IREDELL COUNTY HEALTH DEPARTMENT

STATESVILLE 704-878-5305 CI MOORESVILLE 704-664-5281

IMPROVEMENT PERMIT / AUTHORIZATION TO CONSTRUCT / OPERATION PERMIT / EXISTING SYSTEM INSPECTION

PERMIT# 120413 PIN# 4629-59-9126 DATE 8-25-04

OWNER OR CONTRACTOR MARK SPENLER / PAULA BOSTIC / EAGLE WING BLDRS PHONE: Business 704-634-4776 Home

ADDRESS 1471 Nightingale Ave Scott AFB, ILL / 3937 GRANITE ST. TERRELL, N.C. 28682

LOCATION STATE PARK RD Ⓛ Wildlife RD Ⓡ STEERWOOD Ⓛ DEERRUN Ⓡ EAGLE CHASE Ⓛ HAWKRUN SFE 36 ON LEFT / LOT 36 LW

SUBDIVISION Wildlife BAY BLOCK / SECTION LOT 36/36A LOT AREA .64AC TD, .044SH SFE SITE CLASS. PS DESIGN FLOW 360 L.T.A.R. .35 SFE / .35 LW-DISP. DISH REPAIR

Septic Tank: 1000 Gallons; STB 312 Date 10-19-04

Pump Tank: 1000 Gallons; PT 283 Date 9-7-04

Pump Make: MYERS Model MSOS 11 Serial No.

Nitrification Field: No Fields 1 Square Feet EU=1200 Linear Feet 200'

No Lines 5x40' Trench Width 24" Max Trench Bottom Depth 36" Gravel Depth N/A

☒ New System ☐ Repair System Type: I, II, ⓘIII, IV, V, VI

System Description: PM 50% RED

Repair System Description: LP 50% RED

Maintenance Agreement Required: ☐ Yes ☐ No

☐ Slab ☒ Crawl Space ☐ Basement w/plumbing ☐ Basement wo/plumbing

☒ House/Mod. Home No. Bedrooms 3

☐ Mobile Home No. Bathrooms 2

☐ Business No. Employees

☐ Other


Water Supply:
☐ Individual
☒ Public
☒ Community

Comments:/Conditions: ① THIS PERMIT SERVES AS A REDRAW ONLY CHANGES WERE THE HOUSE SLIDING UP & TANK LOCATIONS CHANGING. REPAIR ALSO LOCATED IN BACK AS DRAWN ② INSTALL LINES ON CONTOURS AS SHOWN


Comments:/Conditions: SETBACKS. POLYLOK EFFLUENT FILTER & RISERS. ✓ TANKS & LINES 12-6-04. 12-7-04 ✓'D SUPPLY LINE, 30" & 2 UNDER DRIVE & SLEEVED

1" = 50'

INITIAL SITE SKETCH

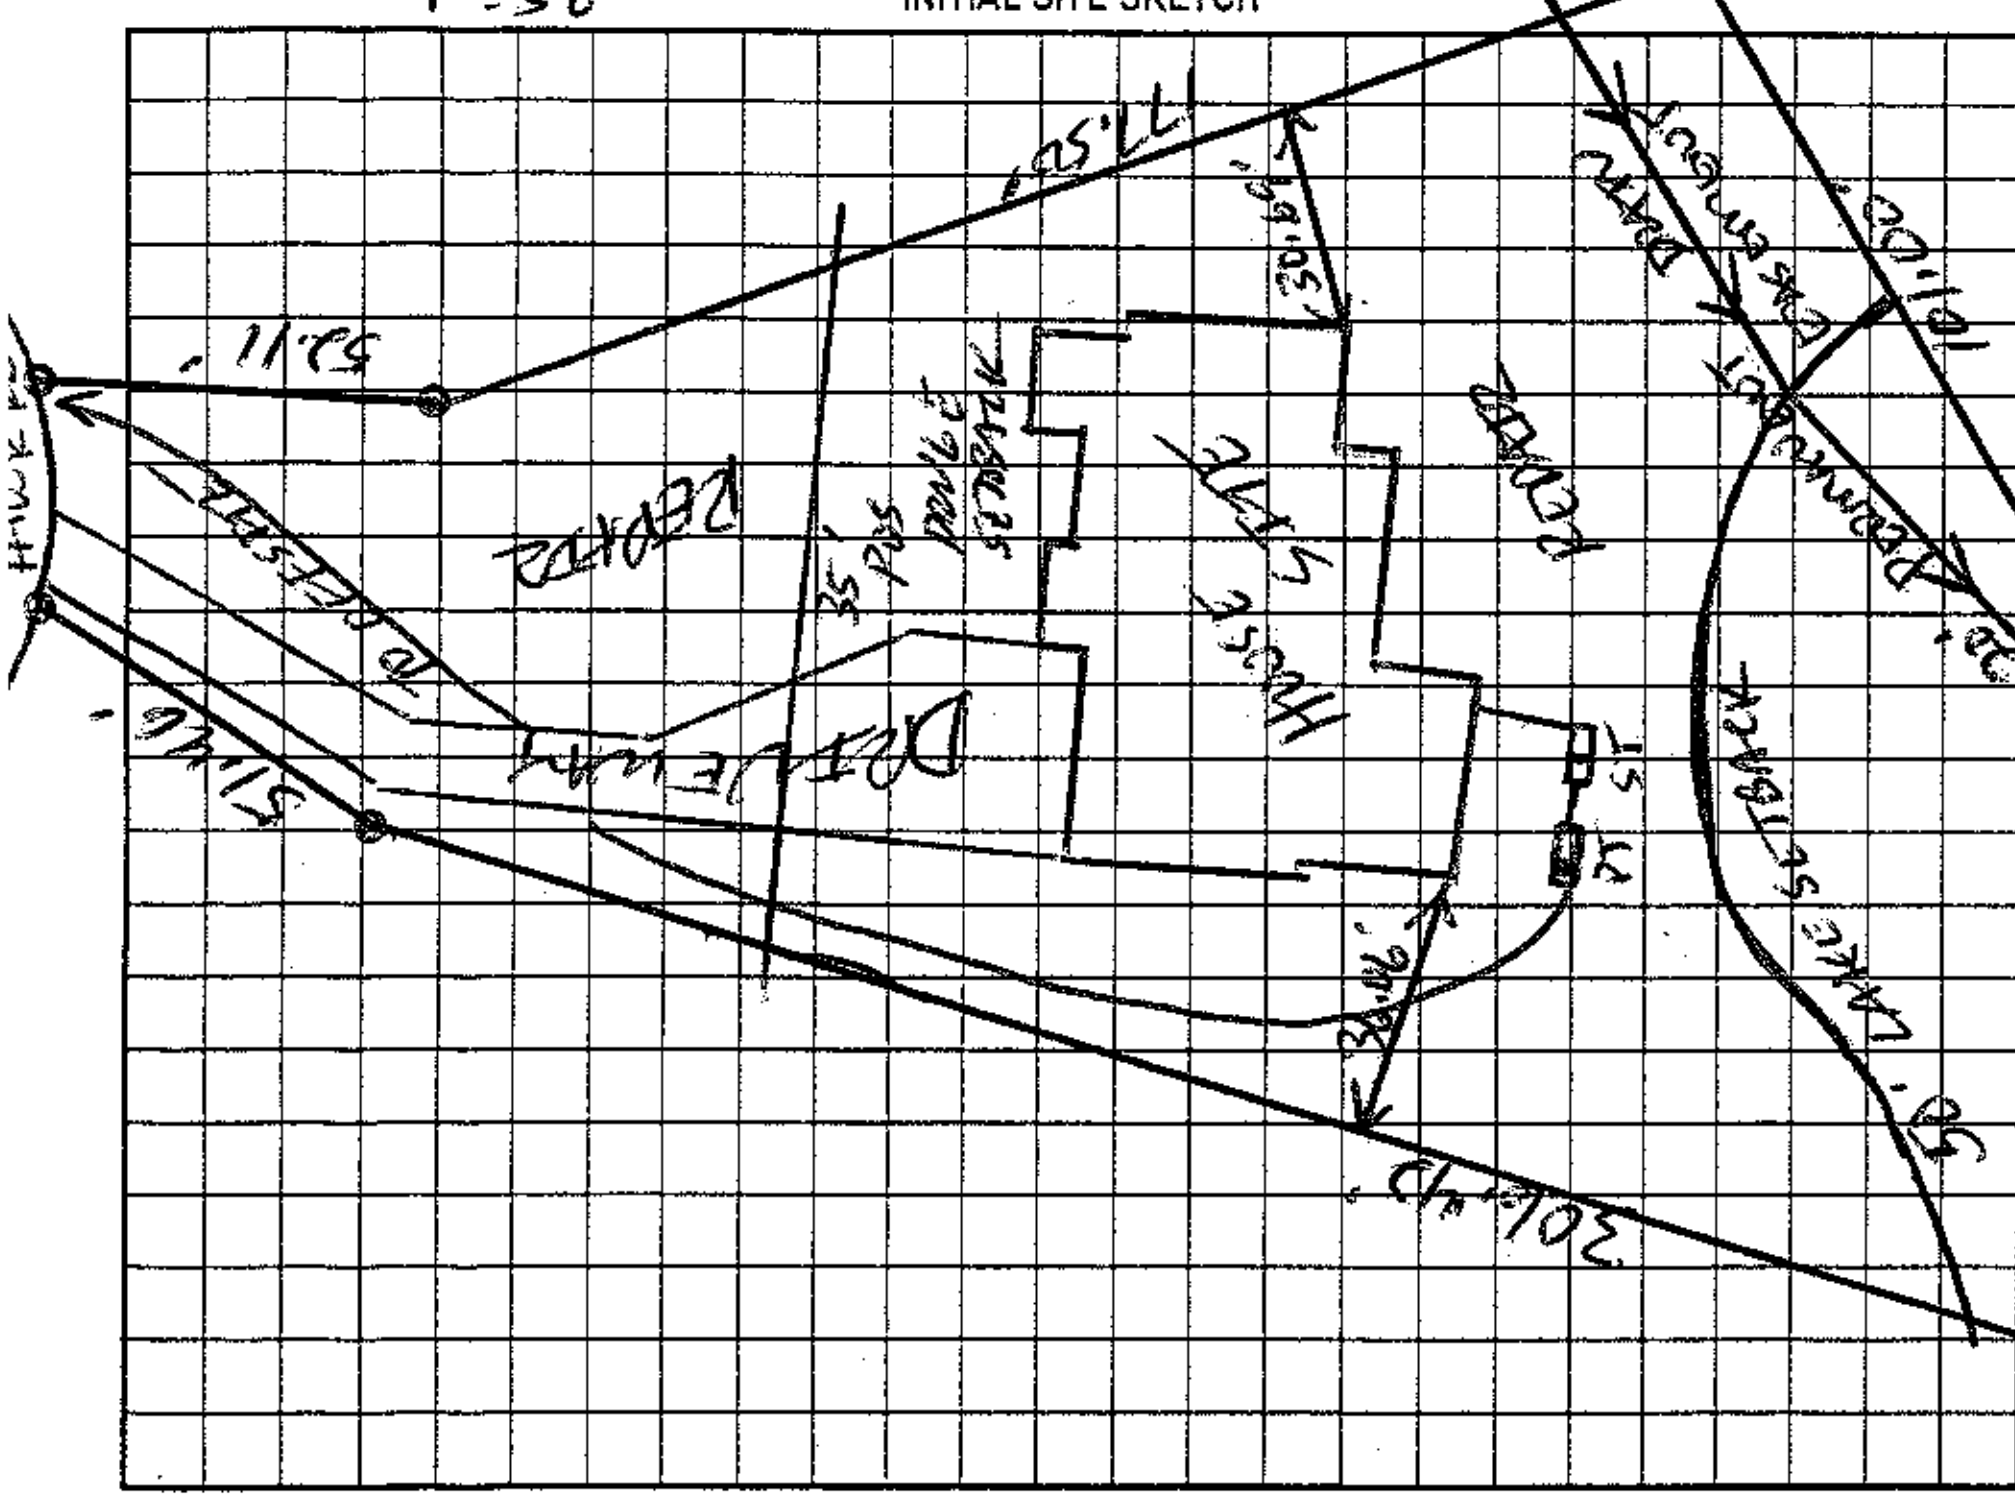

AS BUILT SKETCH

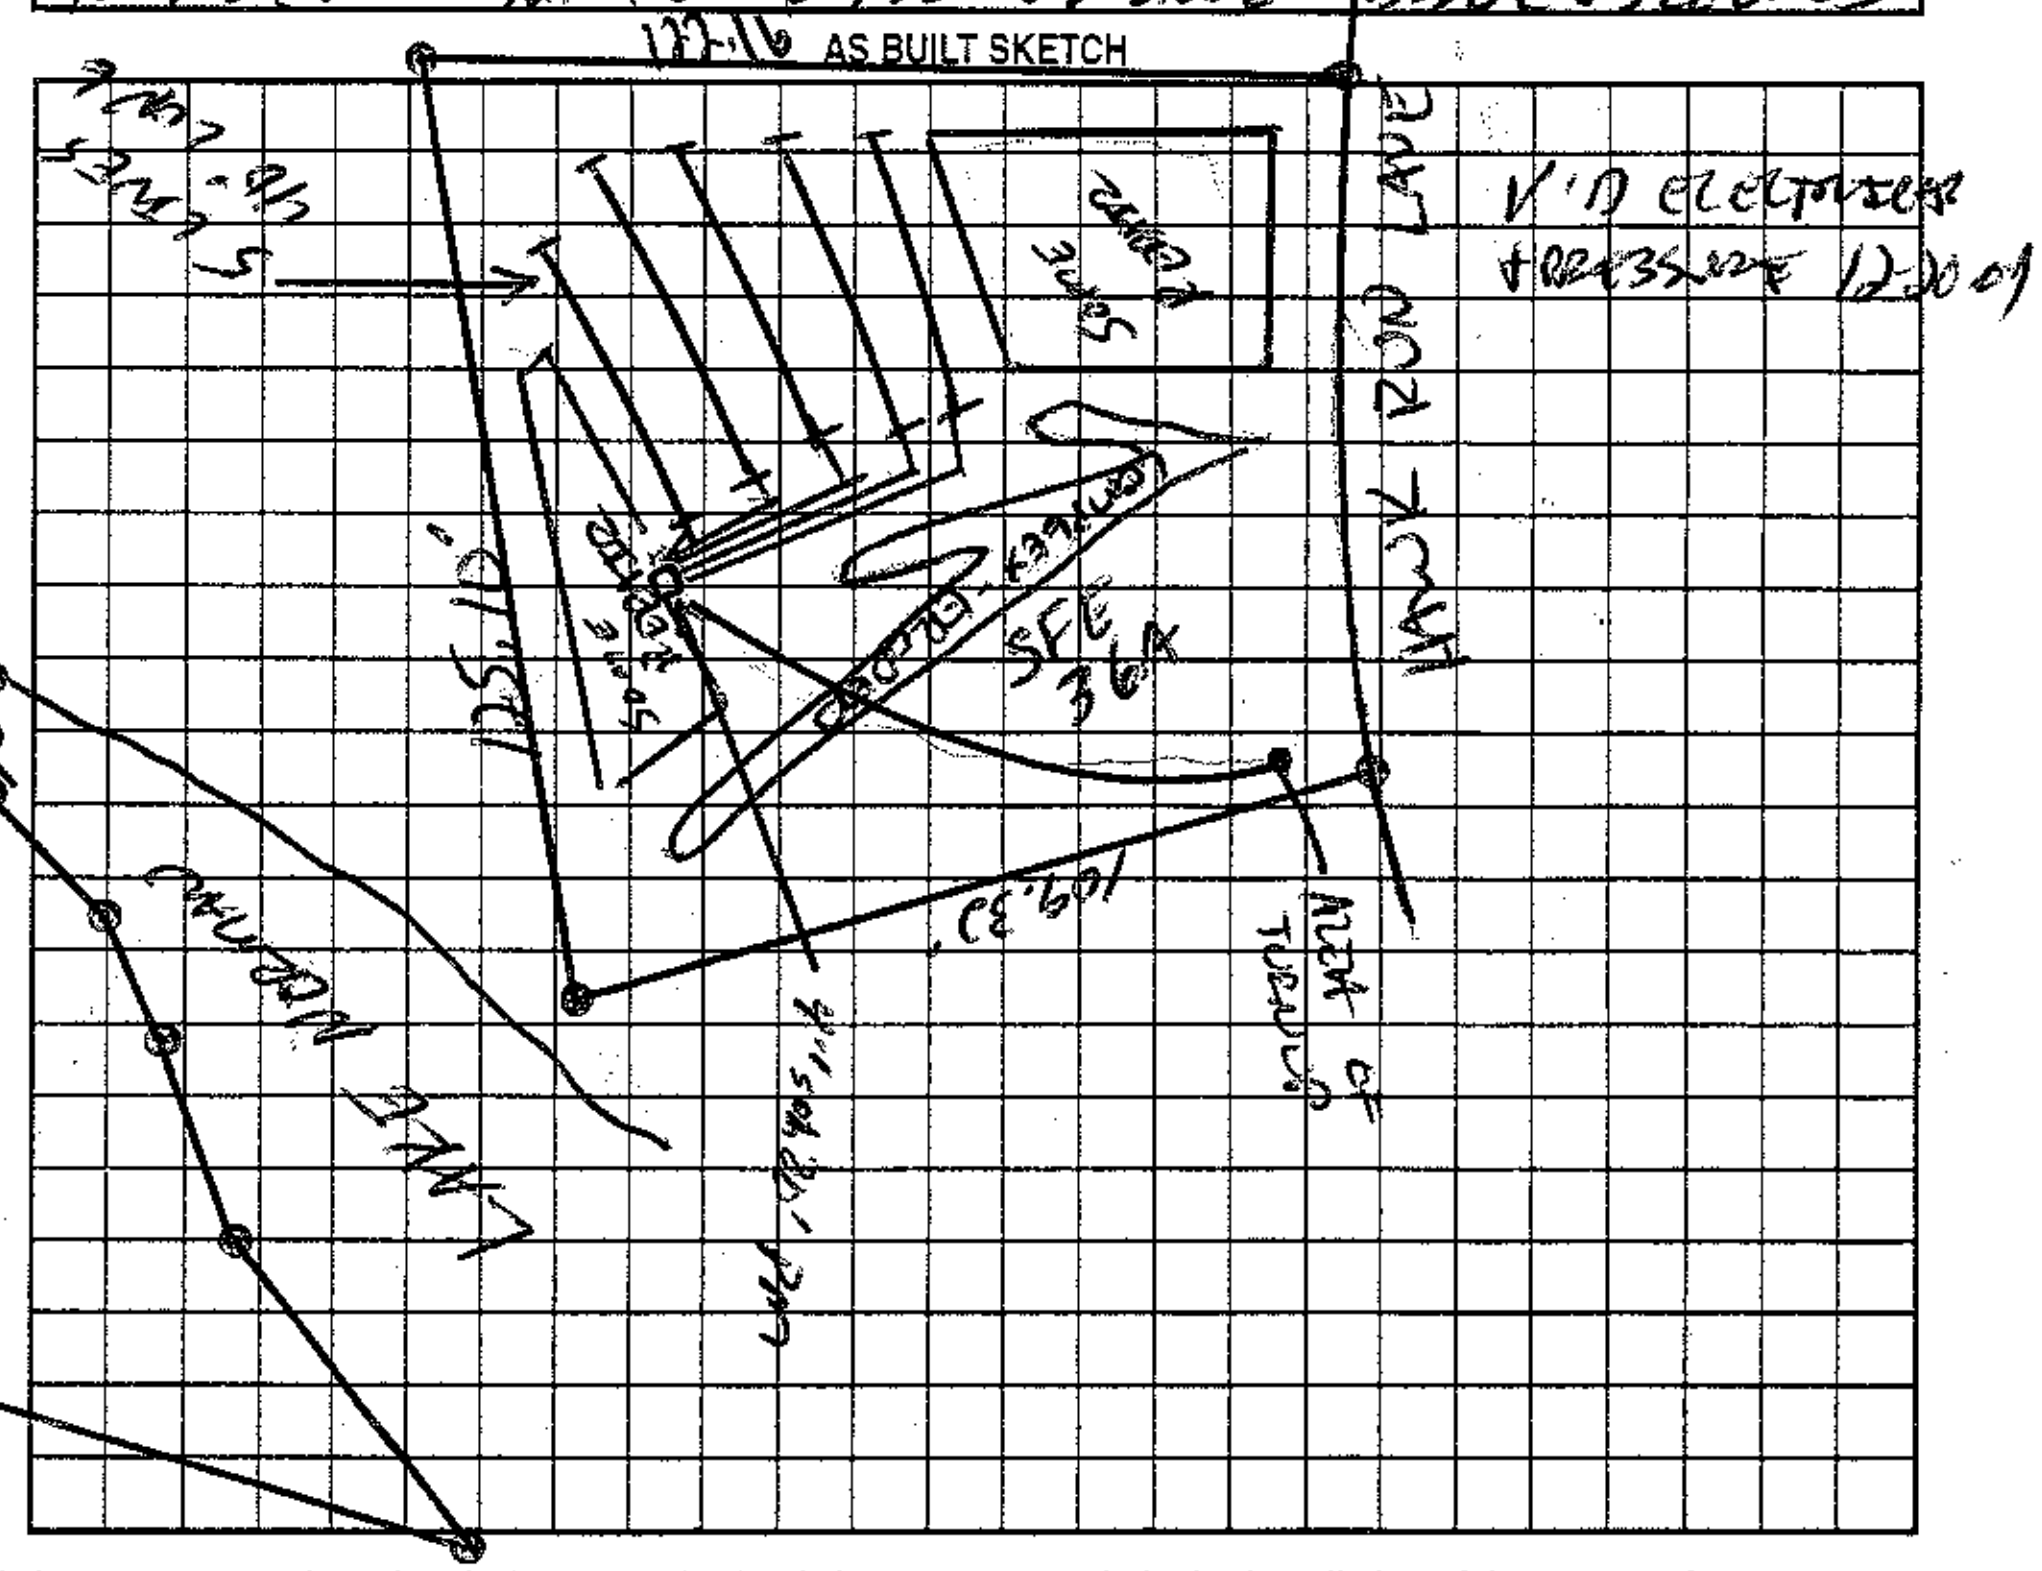

Permit can be suspended or revoked if any false information is supplied toward securing the permit/any unauthorized changes are made to the site/any unauthorized changes are made in the installation of the system. Improvement Permit with plat valid without expiration. Improvement Permit with site plan valid for sixty months. Authorization to Construct is valid for a period equal to that of Improvement Permit – not to exceed sixty months.

Signed: Paula J Bostic date 10/20/04 Installed by: R. ABERNATHY

Improvement Permit by: [signature] date 8-25-04 Operation Permit by: [signature] date 12-20-04

Authorization to Construct by: [signature] date 8-25-04 Existing System Inspection by: date

HEALTH DEPT. COPY: WHITE OWNER COPY (FINAL): YELLOW OWNER COPY (INITIAL): PINK