IREDELL COUNTY HEALTH DEPARTMENT

Statesville Office (704) 878-5305 Mooresville Office (704) 660-3625 PERMIT # 215883

IMPROVEMENT PERMIT / AUTHORIZATION TO CONSTRUCT / OPERATION PERMIT / EXISTING SYSTEM

PIN # 4629603052

APPLICANT: Becky Bean / Allen tate Realtors APPLICANT ADDRESS: 634 River Hwy Mooresville NC 28117

SITE ADDRESS: 202 Allendale Cir Troutman NC 28166 PHONE: 980/721-4312 ALT. PHONE: 704-299-1063

SITE DIRECTIONS: 215 T/R Perth/Wagner T/R State Park Rd T/L Moorson Farm Rd T/R Allendale Cir lot on right

SUBDIVISION: Allendale Point SECTION: N/A LOT # 13 LOT AREA: 0.48ac DESIGN FLOW: Ex L.T.A.R.: Ex


Septic Tank	1000 (gal)	STB	760	Date	7-28-15	☐ New System	☒ Repair	☐ Expansion	System Type: I ☒ III IV V VI
Pump Tank	W/A (gal)	PT	W/A	Date	W/A	System Description:	Tank		
Pump Make	N/A	Model	Poly/Lock	Serial #	PL-68	Repair System Description:			
# Nitrification Fields	Ex	# Lines	Ex	Linear Ft:	Ex	Maintenance Agreement Required:	☐ YES	☒ NO	
Trench Width	Ex	Max. Trench Bottom Depth	Ex	Gravel Depth	Ex	☒ GRAVITY	☐ PRESSURE		

☒ Residence No. Bedrooms Ex
☐ Business No. Persons Ex
☐ Other No. Employees
☐ Slab ☐ Crawl Space
☒ Basement w/plumbing ☐ Basement w/o plumbing

Water Supply
☒ Private
☐ Public
☐ Community

Comments / Conditions: Pump/crush and fill existing tank. Maintain no greater than 6" of cover or use risers. Maintain 350' off well

INITIAL SITE SKETCH

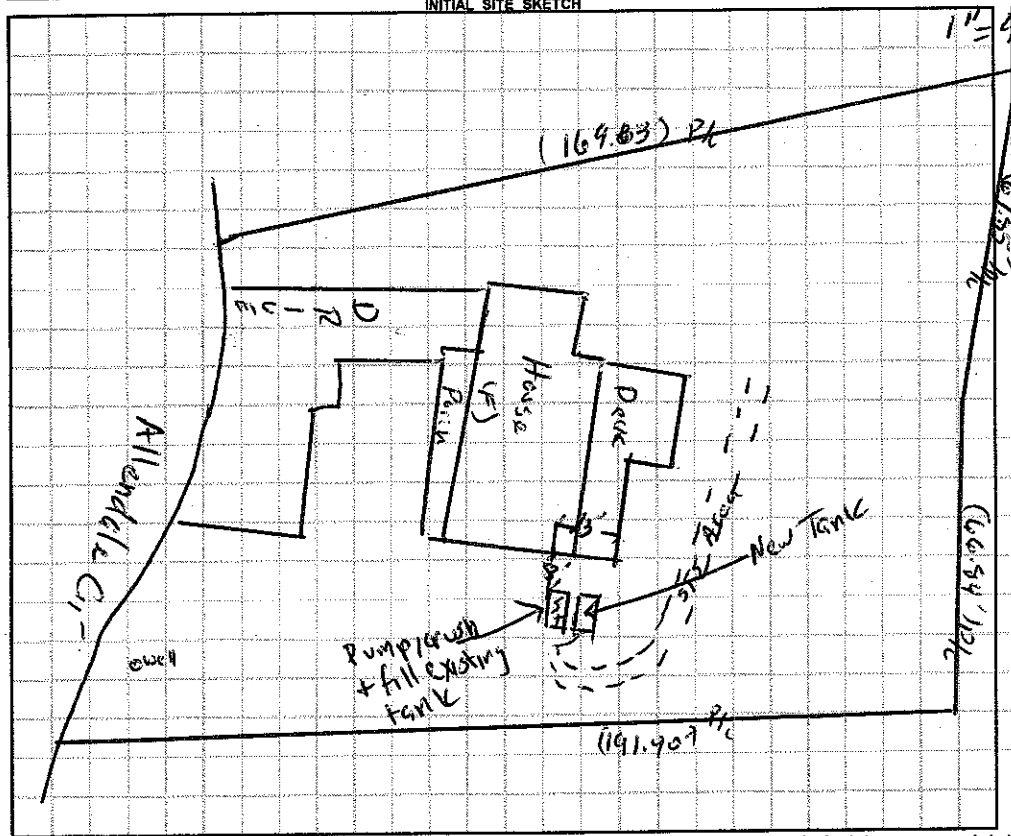

AS BUILT SKETCH

Installed as drawn

Permit can be suspended or revoked if any false information is supplied toward securing the permit / any unauthorized changes are made to the site / any unauthorized changes are made in the installation of the system. CONTACT A LOCATOR SERVICE PRIOR TO ANY EXCAVATION

☐ IMPROVEMENT PERMIT *with plat* valid without expiration. ☒ IMPROVEMENT PERMIT *with site plan* valid for 60 mos. ☒ AUTHORIZATION TO CONSTRUCT valid for period equal to IMPROVEMENT PERMIT--not to exceed 60 mo.

Owner / Applicant Signature: Rebecca G. Bean Date: 1/19/16 Installed by: Lentz Wastewater

IMPROVEMENT PERMIT by: Date: 01/11/16 OPERATION PERMIT by: Date: 01/20/16

AUTHORIZATION TO CONSTRUCT by: Date: 01/11/16 Existing System Inspected by: Date:

Health Dept. Copy - WHITE Applicant (Final Approval) - YELLOW Applicant (Conditional Approval) - PINK