IREDELL COUNTY HEALTH DEPARTMENT

Statesville Phone TR 3-7271 Mooresville Phone MO 3-1271

PERMIT TO INSTALL SEPTIC TANK

Permit NO. _____ Permit Date 11/4/ 19 69

Owner W. L. Moser Address Valley Stream

Installed By C Yoke + Sons Address R 7


Location of Property Lake Lake Point #8

Tank	Capacity	Length of Lines	Fixtures
Block	1000	225' ( )	No. of Baths 1½
Precast	1250 ✓	250' ( )	Dishwasher
	1500	Other 240	Garbage Distr.
	Other		Other

NOTIFY HEALTH DEPARTMENT AT LEAST EIGHT HOURS BEFORE TANK IS TO BE INSPECTED.

Final Inspection _____ 19__ Approved ( ) Disapproved ( )

Remarks: Set pit off water + well

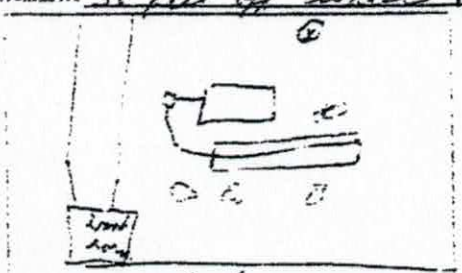

Sketch of Installation

Sanitarian

JAN. 11, 1989 13:06