IREDELL COUNTY HEALTH DEPARTMENT

STATESVILLE 704-878-5305 MOORESVILLE 704-664-5281

IMPROVEMENT PERMIT / AUTHORIZATION TO CONSTRUCT / OPERATION PERMIT / EXISTING SYSTEM INSPECTION

PERMIT# Repair PIN#

OWNER OR CONTRACTOR Kris Davis PHONE: Business Cell # (704) 651-6162 Home (704) 528-3460 DATE 5/15/01

ADDRESS 178 Allendale Circle Troutman N.C. 28166

LOCATION Pearson Farm Rd to end, (R) Allendale Circle, 5th on Right

SUBDIVISION Allendale Point BLOCK / SECTION — LOT 8 LOT AREA SITE CLASS 15 DESIGN FLOW 360 L.T.A.R.

Septic Tank 1,000 Gallons: STB Date

Pump Tank: 1,000 Gallons: PT Date

Pump Make: Model Serial No.

Nitrification Field: No Fields Square Feet Linear Feet 165

No Lines 5 Trench Width 36" Max Trench Bottom Depth 36" Gravel Depth Sand-6"

(38 Panels)

☐ New System ☒ Repair System Type: I. II. III. (IV.) V. VI

System Description:

Repair System Description: Pump, Pressure dose Panels

Maintenance Agreement Required: ☒ Yes ☐ No

☐ Slab ☐ Crawl Space ☒ Basement w/plumbing ☐ Basement wo/plumbing

☒ House/Mod. Home No. Bedrooms 3

☐ Mobile Home No. Bathrooms 3

☐ Business No. Employees


☐ Other

Water Supply: ☒ Individual ☐ Public ☐ Community

Comments/Conditions: (1) Install 4- 30ft Lines and One (1) 45 ft Lines of Pressure dosed PBBS (Panels) System (2) Keep 5ft off property lines + 50ft From well (3) ~~[redacted]~~ A Contract shall be executed between System owner and a Management Entity prior to issuance of operation permits. (38 Panels Installed - 1671 ft)

Inspected Alarm + Electrical 12/19 - WJF


INITIAL SITE SKETCH

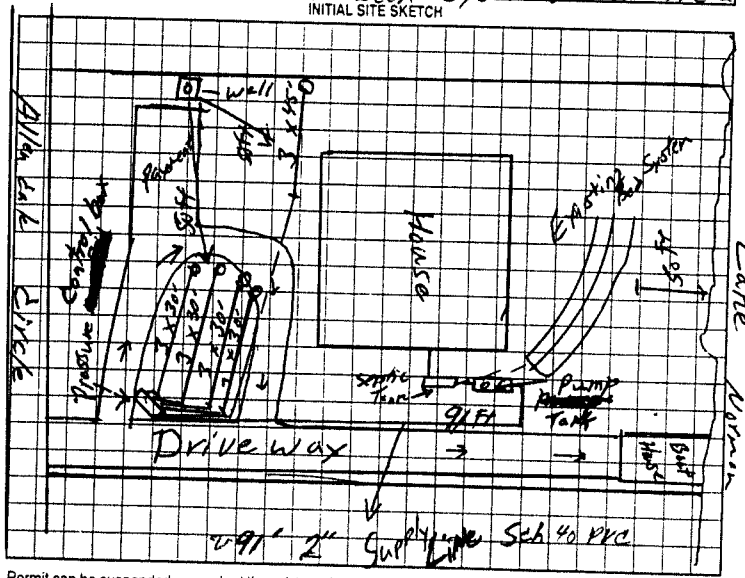

AS BUILT SKETCH

Checked Pressure Head + Pump, Lines - okay 3/22/02

Sim Tech Filter Inspected - okay 3/25/02

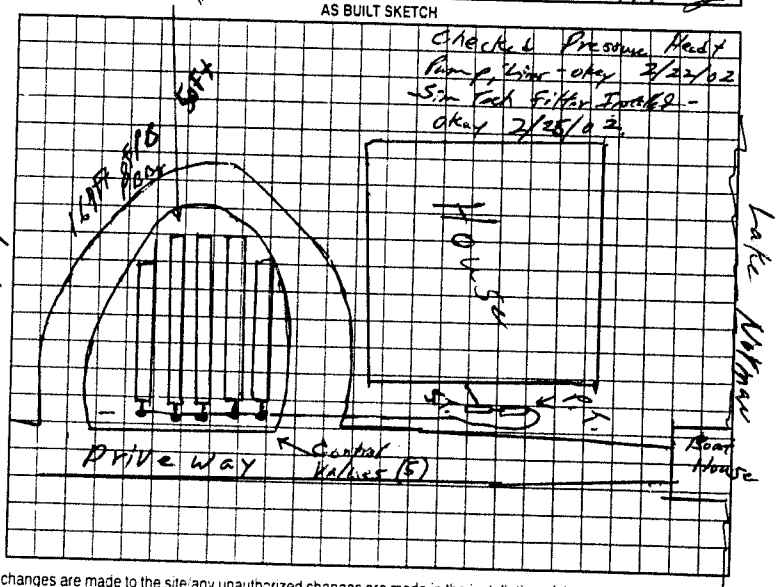

Permit can be suspended or revoked if any false information is supplied toward securing the permit/any unauthorized changes are made to the site/any unauthorized changes are made in the installation of the system. Improvement Permit with plat valid without expiration. Improvement Permit with site plan valid for sixty months. Authorization to Construct is valid for a period equal to that of Improvement Permit – not to exceed sixty months.

Signed: M. Fun date

Improvement Permit by: William O. Johnson date 5/15/01

Authorization to Construct by: William O. Johnson date 5/15/01

Installed by: Richard Abernathy

Operation Permit by: William O. Johnson date 3/25/02

Existing System Inspection by: date

HEALTH DEPT COPY WHITE OWNER COPY (FINAL) YELLOW OWNER COPY (INITIAL) PINK