IREDELL COUNTY HEALTH DEPARTMENT

STATESVILLE 704-878-5305 MOORESVILLE 704-664-5281

IMPROVEMENT PERMIT / CERTIFICATE OF COMPLETION / OPERATION PERMIT / EXISTING SYSTEM INSPECTION

PROPERTY DESCRIPTION NO. Repair DATE 6-25-93 TAX MAP NO. Repair

OWNER OR CONTRACTOR Claude Madison PHONE: Business Home 872-3289

ADDRESS

LOCATION Morrison Farm Rd TR Allendale, TL 2nd intersection, 1st house on L

SUBDIVISION BLOCK / SECTION LOT LOT AREA SITE CLASS. L.T.A.R.

Water Supply: ☑ Individual ☐ Community ☐ Public Well

Septic Tank: Existing Gallons: STB — Date —

Pump Tank: 1000 Gallons: PT PT 10 Date 4-19-93

Nitrification Field: No Fields 2 Square Feet 570 Linear Feet 190'

No Lines 3 Trench Width 36" Trench Depth 36" Gravel Depth 12"

☐ New System ☑ Repair System Type: I. II. III. IV. V. VI

System Description: Pump to conventional

Repair System Description:

Maintenance Agreement Required: ☐ Yes ☐ No

☑ House/Mod. Home ☐ Mobile Home ☐ Business ☐ Other

No. Bedrooms 4 No. Bathrooms 2 No. Employees —

Garbage Disposal: ☐ Yes ☑ No

Auto. Dishwasher: ☑ Yes ☐ No

Auto. Washing Machine: ☑ Yes ☐ No


Other

☐ Slab ☐ Crawl Space ☑ Basement w/plumbing ☐ Basement wo/plumbing

Comments Setting #1 on bull-run-valve to existing system, setting #2 to pump tank.

INITIAL SITE SKETCH

AS BUILT SKETCH

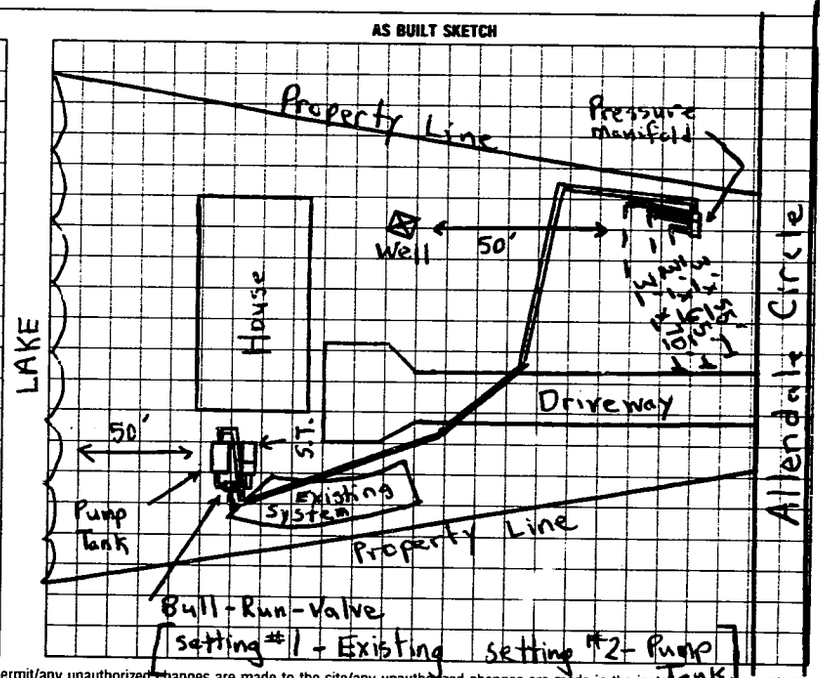

I understand that this permit can be suspended or revoked if any false information is supplied toward securing the permit/any unauthorized changes are made to the site/any unauthorized changes are made in the installation of the system. Improvement Permit is valid for 60 months from date of issuance.

Signed:

Improvement Permit by: J.C. Moore / Michael J. Dennis date 5-25-93

Existing System Inspection by: date

Installed by: Yountz's Backhoe service

Certificate of Completion by: Michael J. Dennis / J.C. Moore date 6-25-93

Operation Permit by: date

HEALTH DEPT. COPY: WHITE INSPECTION COPY (FINAL): GREEN OWNER COPY (FINAL): YELLOW INSPECTION COPY (INITIAL): PINK OWNER COPY (INITIAL): GOLD

J