ICHD–ENVIRONMENTAL HEALTH DIVISION

PJB

Statesville Office (704) 878-5305 Mooresville Office (704) 660-3625 PERMIT # 2463 43

SEPTIC IMPROVEMENT PERMIT / AUTHORIZATION TO CONSTRUCT / OPERATION PERMIT / EXISTING SYSTEM

PIN # 4629609321

APPLICANT/OWNER: Kevin Day APPLICANT ADDRESS: 248 Allendale Circle Troutman, NC

SITE ADDRESS: 248 Allendale Circle Troutman, NC 28166 PHONE: 704-634-6275 ALT. PHONE

SITE DIRECTIONS: State Park Rd → L on Morrison Farm → R on Allendale → turn L → lot on L SAP CONTROLLED: ☐ YES ☐ NO

SUBDIVISION: Allendale Point SECTION: — LOT # 26 LOT AREA: .46 ac DESIGN FLOW: 360gpd L.T.A.R.:

Septic Tank 1000 (gal) STB Infiltrator Date 7-8-2021

Pump Tank 1000 (gal) PT Infiltrator Date 7-8-2021

Pump Make Model Serial #

Nitrification Fields # Lines Lineal Ft

Trench Width EXISTING Trench Bottom Depth(low side) Gravel Depth

☐ New System ☐ Repair ☐ Expansion System Type: I II III IV V VI

System Description:

Repair System Description: tank replacement

Maintenance Agreement Required: ☐ YES ☑ NO

☐ GRAVITY ☑ PRESSURE

☑ Residence No. Bedrooms 3

☐ Business No. Persons 6

☐ Other No. Employees


☐ Slab ☐ Crawl Space

☑ Basement w/plumbing ☐ Basement w/o plumbing

Water Supply: ☑ Private ☐ Public ☐ Community

Comments / Conditions: Pump, crush, & fill existing tanks. No retaining wall to be built within 10' of new tanks. * Grade is to change → if more than 3' of cover is going to be placed on tanks, traffic rated tanks are required. Maintain 5' from porch or steps.

INITIAL SITE SKETCH

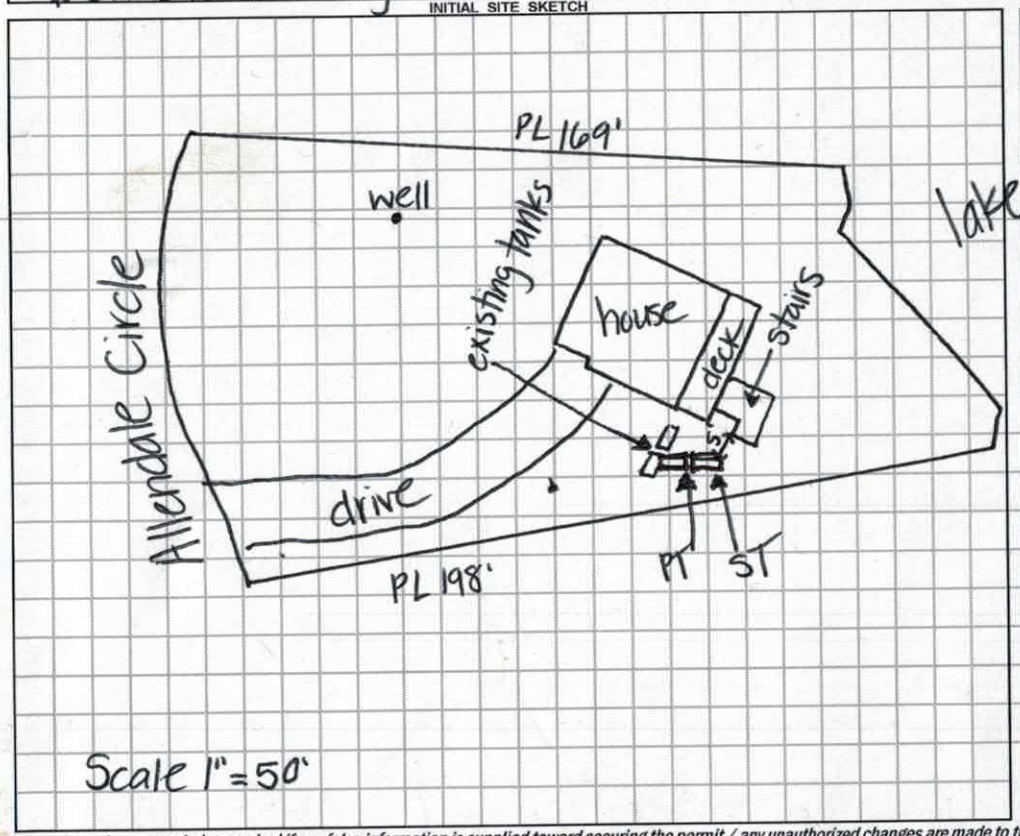

Scale 1" = 50'

AS BUILT SKETCH

* Re-used Pump.

	Date	Initials
Drain Lines Checked		
Tanks Checked	7/10	BB
Pressure Manifold or Valve Box Checked		
Pressure Head Set		
Electrical Checked	7.15.19	PB
Floats Set		
Alarm Checked		
Maintenance Contract Y / N	N - A	

* Filter in Tank 7/11
* Risers ✓
* Pump Line. ✓ CC

Permit can be suspended or revoked if any false information is supplied toward securing the permit / any unauthorized changes are made to the site / any unauthorized changes are made in the installation of the system. **CONTACT A LOCATOR SERVICE PRIOR TO ANY EXCAVATION**


☐ **IMPROVEMENT PERMIT** *with plat valid without expiration.* ☑ **IMPROVEMENT PERMIT** *with site plan valid for 60 mos.* ☑ **AUTHORIZATION TO CONSTRUCT** *valid for period equal to IMPROVEMENT PERMIT--not to exceed 60 mo.*

Owner / Applicant Signature: Date: 7/05/2019 Installed by: Tim Ammons

IMPROVEMENT PERMIT by: Kayla Wilson Date: 7-5-19 OPERATION PERMIT by: Patrick Boyle III (as) Date: 7-15-19

AUTHORIZATION TO CONSTRUCT by: Kayla Wilson Date: 7-5-19 Existing System Inspected by: Date:

FOR SEPTIC FINAL INSPECTION: CALL 704-664-3703 between 8am-9am the day the inspection is needed. Be sure to speak with an inpsector to confirm your inspection time.

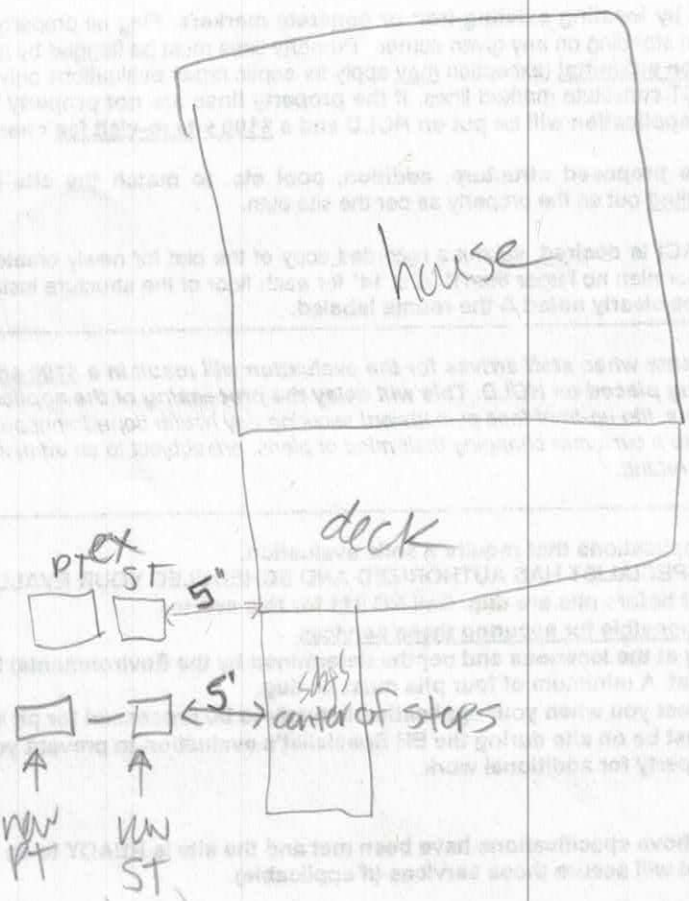

*no retaining wall to be within 10' of new tanks
grade is to change → if more than 3' of cover is on top of tanks, traffic rated tanks will be required

#2960595
7.3.19
$0

APPLICATION MUST BE FILLED OUT COMPLETELY & BE LEGIBLE OR IT WILL NOT BE PROCESSED

Iredell County Health Department – Environmental Health Division

PAGE 1: *APPLICATION FORM*

Application For: ( ) New Well Permit ( ) Well Repair Permit ( ) Well Abandonment
( ) Septic Improvement Permit ( ) Authorization to Construct ( ) Existing System Inspection (✓) Septic System Repair

THE ABOVE PERMIT DOCUMENTS WILL BECOME INVALID IF INFORMATION PROVIDED ON THIS APPLICATION IS FALSIFIED OR CHANGED, OR IF THE SITE IS ALTERED. THE IMPROVEMENT PERMIT IS VALID FOR EITHER 60 MONTHS OR WITHOUT EXPIRATION DEPENDING UPON DOCUMENTATION SUBMITTED. APPLICATION WITH SITE PLAN 60 MONTHS, APPLICATION WITH COMPLETE, SCALED PLAT WITHOUT EXPIRATION. SEE 15A NCAC 18A .1937(f) FOR DETAILS.

Page 2: *Site Plan Worksheet* form MUST accompany this application

The following optional attachments may also be submitted: ( ) Survey Plat, scaled no more than 1 inch = 60 feet
Place an (X) *beside whichever is submitted if applicable* ( ) Custom Site Plan, scaled no more than 1 inch = 60 feet

Applicant Information: (PRINT CLEARLY)

Applicant Name: Kevin Day **Address:** 248 Allendale Circle Troutman **Zip:** 28166

Applicant Email: Kday@axionfoundations.com **Phone:** 704-634-6275 **Alt. Phone:** _____

Owner Name: Same **Address:** _____ **Zip:** _____

Owner Email: _____ **Phone:** _____ **Alt. Phone:** _____

Property Information:

Street Address: 248 Allendale circle Troutman, NC 28166

Subdivision Name: _____ **Section/Phase:** _____ **Lot Number:** _____

Driving Directions: State Park Rd T/L Morrison Farm Rd T/R Allendale Circle

Site Development Information: *(check or complete ALL that apply*

( ) New Single Family Residence
( ) New Multi-Family Residence
( ) Accessory Building
( ) Bedroom(s) Addition
(✓) Repair to failing septic system ✓ Tank ___ Drain lines Describe Problem: _____

Maximum Number of Bedrooms: _____
Maximum Number of Occupants: _____
( ) Swimming Pool
( ) Other Addition/Structure: _____

CHECK FOUNDATION TYPE
( ) Crawl Space Foundation
( ) Concrete Slab Foundation
(✓) Basement with Plumbing
( ) Basement without Plumbing

Non-Residential Site Development: Type of Business: _____
Square Footage of Building: _____ Max. Number of Employees: _____ Max. Number of Seats/Beds/Other: _____

Water Supply: ( ) Replacement Well – Reason: _____
( ) Multi-connection Well Number of Houses: _____ Number of Persons: _____

( ) New Well (X) Existing Well ( ) Community Well ( ) City Water ( ) Other Public Water

Desired Septic System Type: *(you may rank in order of preference)* Year existing system installed: 1984
( ) No Preference ( ) Alternative ( ) Conventional ( ) Innovative ( ) Modified Conventional ( ) Other: _____

Please answer the following to the best of your ability:
( ) Yes (✓) No Does the site contain any jurisdictional wetlands?
( ) Yes (✓) No Is any non-domestic sewage (i.e. industrial) to be generated?
( ) Yes (✓) No Is the site subject to approval by any other public agency?


I have read this application and certify that the information provided herein is true, complete, and correct. Authorized county and state officials are granted right of entry to conduct necessary inspections to determine compliance with applicable laws and rules. I understand that I am solely responsible for the proper identification and labeling of all property lines and corners and making the site accessible so that a complete site evaluation can be performed.

Signature: _____ 7/03/2019
Property owner or owner's legal representative signature (SIGNATURE REQUIRED) DATE

IREDELL COUNTY DEPARTMENT of ENVIRONMENTAL HEALTH

SITE PLAN WORKSHEET

SEE THE "SAMPLE SITE PLAN" BELOW. *INCOMPLETE SITE PLANS WILL BE RETURNED TO YOU FOR COMPLETION AND MAY RESULT IN A DELAY IN THE ISSUANCE OF YOUR SEPTIC SYSTEM OR WELL PERMIT!!!*

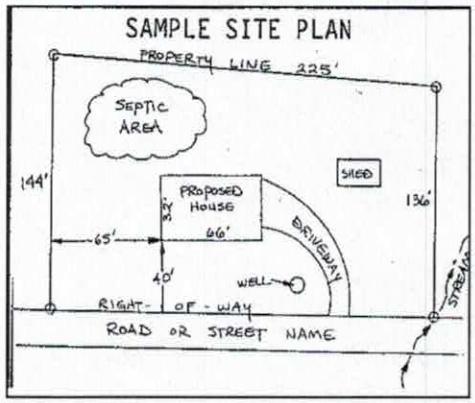

Place an (X) beside each item as you complete the site plan:


- ( ) Property Line measurements are clearly identified
- ( ) All proposed structures are indicated
- ( ) Front and side setbacks from property line
- ( ) Preferred driveway location
- ( ) Preferred well location
- ( ) Preferred septic system location
- ( ) North arrow, or other sufficient indicator of direction

Circle N/A on the following if appropriate:

Location of septic systems and wells within 100' of your property	N/A
Location of easements and rights of ways on your property	N/A
Location of any designated wetlands on the property	N/A

USE THIS SPACE TO DRAW YOUR SITE PLAN

Show: proposed house or business footprint, wells, water lines, patios, pools and decks, and any other item that will occupy space on the site

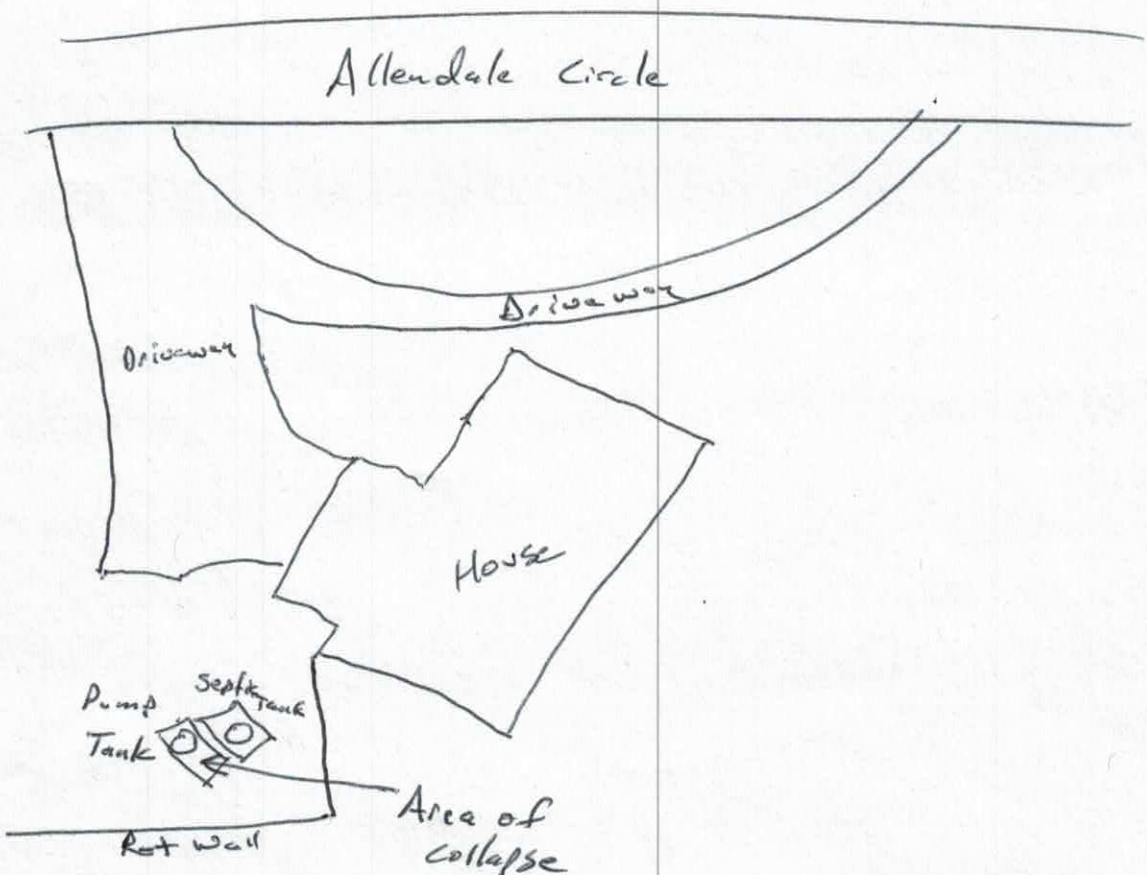

Signature: _____ 7/03/2019

Property owner or owner's legal representative signature (SIGNATURE REQUIRED) **DATE**

IREDELL COUNTY HEALTH DEPARTMENT

(SEPTIC TANK) IMPROVEMENTS PERMIT AND CERTIFICATE OF COMPLETION
(Ground Absorption Sewage Disposal System -- G. S. Chapter 130-Article 13C)

OWNER OR CONTRACTOR WESLEY SHERRILL DATE 4-14-89 PERMIT NO 17D.

PHONE: Business _____ Home _____

LOCATION Morrison Town Rd. all the way around T.R. on Allendale Rd. go 1/4 mi. on left. S. R. No. _____

SUBDIVISION NAME ALLENDALE POINT LOT NO. 26 SECTION OR BLOCK NO. _____

House (✓) Mobile Home ( ) Business ( ) Other Repair.

No. Bedrooms 3 No. Bathrooms 1.5

Garbage Disposal Unit Yes ( ) No (✓)
Auto. Dishwasher Yes ( ) No (✓)
Auto. Wash. Machine Yes (✓) No ( )
Site Suitable Yes (✓) No ( )


Character & Porosity of Soil _____
Percolation Rate _____
Topography Repair.
Depth to Water Table _____
Rock or other impervious formations _____

Lot Area Ample.

_____ Basement with Plumbing _____ Basement Without Plumbing _____ No Basement

Size of Tank 1000 x 1000 PUMP TANK Gals.

Nitrification Field:
No. of Lines _____
Sq. Ft. _____ Linear Ft. _____
Depth of Stone in Lines _____
Water Supply: Individual (✓)
Public ( )

 

Plot of System

Installed by Mike Holland

I understand and agree to install septic tank system as specified on this Improvements Permit.

Signed: _____

IMPROVEMENTS PERMIT BY Steve Brown

COMMENTS: Set 20' existing 4" grade drain line down 4" Vac set off. Will set 4" grade sewer drain line

CERTIFICATE OF COMPLETION BY Steve Brown DATE 4-14-89

DATE _____

EXISTING SYSTEM CHECKED BY: _____

CONSTRUCTION MUST COMPLY WITH ALL OTHER APPLICABLE STATE AND LOCAL REGULATIONS.

Permit is VOID if any unauthorized changes are made in installation of system and/or if any false information is supplied in making Improvements Permit

Health Dept Copy: White Inspection Dept. Copy: Yellow Sanitarian's Copy: Pink Owner's Copy: Gold

IREDELL COUNTY DEPARTMENT OF ENVIRONMENTAL HEALTH

DOCUMENTATION TO AUTHORIZE AN OWNER'S LEGAL REPRESENTATIVE

(Check and sign only ONE of the options below)

1. * APPLICANT AND OWNER ARE THE SAME. * (*Sign here*) _____

Applications for permits require the "signature of the owner or owner's legal representative" (15A NCAC 18A .1937). If the owner does not sign the application himself or herself, they can submit any one of the following documents to designate their legal representative: *Power of Attorney; Real Estate Contract; Estate executor; Bankruptcy trustee; Court ordered guardianship*
In the absence of the above documentation, the property owner may provide the local health department with documentation that designates a legal representative. A property owner may:
Complete this form to document his or her legal representative, or provide his or her own form that contains the information in this form. If there are multiple property owners, then all property owners must sign the form that designates a legal representative.
By signing a form that designates a legal representative for purposes of 15A NCAC 18A .1937, the property owner authorizes that representative to act on their behalf in matters pertaining to the application and permitting process, including signing or receiving any application, document or permit. The owner retains full responsibility to meet all permit conditions specified by the local health department.

2. I, Kevin Day, am the legal owner(s) of the property located at 248 Allendale Circle Troutman, NC, identified as

PIN (Parcel Identification Number)_____, located in Iredell County, North Carolina.

I do hereby authorize (**print legal representative/company name**) Tim Ammons, _____, to act as an agent on my behalf in applying for/signing/obtaining any of the documents described below.

- Application for Improvement Permit (IP) / Authorization to Construct (AC)
- Improvement Permit (IP) / Authorization to Construct (AC)
- Application for soil-site evaluation (new/repair)
- Application/permit for private drinking water well/well abandonment
- Application for Compliance Inspection

I agree to abide by all decisions and/or conditions between the legal representative acting on my behalf and the Iredell County Department of Public Health, Environmental Health Division.

_____ 7/03/2019

Signature of Owner(s) Date

Mooresville - Environmental Health
ronda.hart@co.iredell.nc.us
Fax: 704-662-3239
610 E. Center Avenue, Mooresville, NC 28115

Statesville - Environmental Health
adrienne.shea@co.iredell.nc.us
Fax: 704-871-3483
349 N. Center Street, Statesville, NC 28677