IREDELL COUNTY HEALTH DEPARTMENT

STATESVILLE 704-878-5305 MOORESVILLE 704-664-5281

IMPROVEMENT PERMIT / AUTHORIZATION TO CONSTRUCT / OPERATION PERMIT / EXISTING SYSTEM INSPECTIO

PERMIT# 88220 PIN# 4629 60 9768 DATE April 26, 20

OWNER OR CONTRACTOR Larry McDaniel Builders PHONE: Business 336 751-9022 Home

ADDRESS P.O. Box 577 Mocksville NC 27027

LOCATION Hwy 21 S to R Perth Rd R State Park Rd L Morrison Farm R Allendale Lot on Right past 1st Road Fork

SUBDIVISION Allendale Point BLOCK / SECTION LOT 4 LOT AREA .50 Ac SITE CLASS. PS DESIGN FLOW 360 L.T.A.R. .3

Septic Tank: 1000 Gallons; STB 760 Date 5-4-00

Pump Tank: 1000 Gallons; PT 188 Date 4-15-00

Pump Make: Hydromatic Model SHEF 50 Serial No. SHF 5041

Nitrification Field: No Fields 1 Square Feet 1200 sq ft Linear Feet 200

No Lines 4 Trench Width 24" Max Trench Bottom Depth 36" Gravel Depth N/A

☑ New System ☐ Repair System Type: I, II, III, IV, V, VI

System Description: Low Pressure PPBPS

Repair System Description: Partial

Maintenance Agreement Required: ☑ Yes ☐ No

☑ House/Mod. Home No. Bedrooms 3

☐ Mobile Home No. Bathrooms 2

☐ Business No. Employees

☐ Other

☐ Slab ☐ Crawl Space ☑ Basement w/plumbing ☐ Basement wo/plumbing


Water Supply: ☑ Individual ☐ Public ☐ Community — WELL

Comments/Conditions: Maintenance Agreement Required before issuance of Operation Permit 46 panels w/ 33 Ton sand. See Attached for pump and PPBPS information. Locate well max. feasible distance from septic system. (50 ft min.)

Comments/Conditions: Lines, tanks checked 8/31/00 GM

1"=40 ft Scale

INITIAL SITE SKETCH

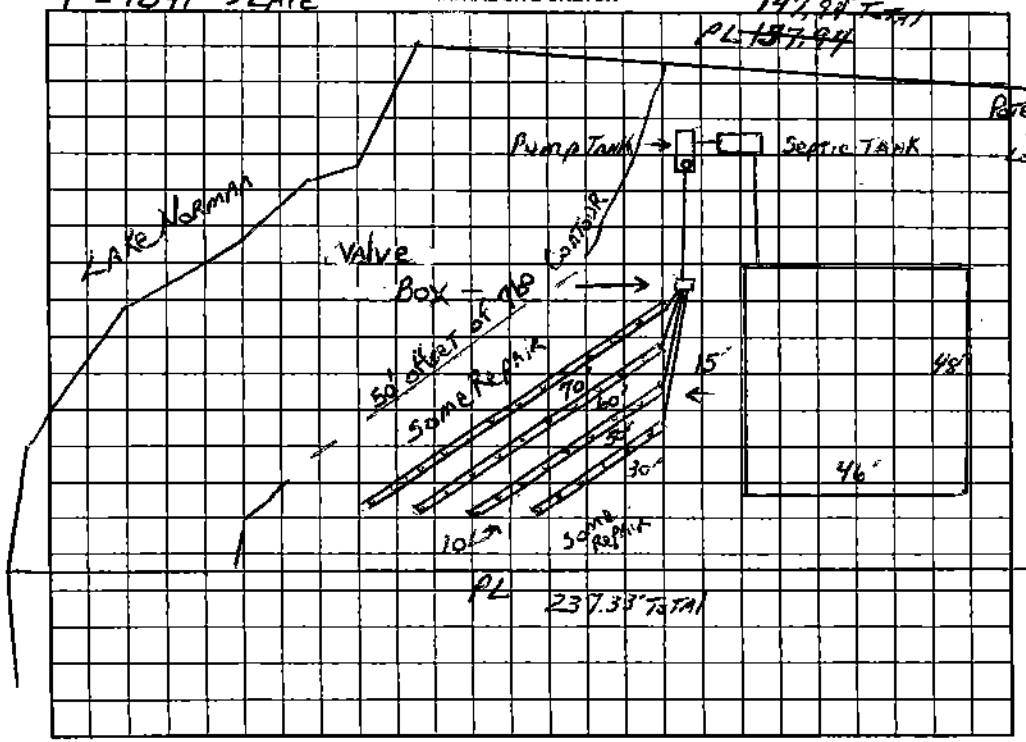

AS BUILT SKETCH

Permit can be suspended or revoked if any false information is supplied toward securing the permit/any unauthorized changes are made to the site/any unauthorized changes are made in the installation of the system. Improvem Permit with plat valid without expiration. Improvement Permit with site plan valid for sixty months. Authorization to Construct is valid for a period equal to that of Improvement Permit – not to exceed sixty months.

Signed: Julie D. Hewett date 5-19-00 Installed by: McDaniel Grading 12-15-00

Improvement Permit by: J. C. Potter date Apr 25 2000 Operation Permit by: [signature] RSP date 12/15/

Authorization to Construct by: J. C. Potter date May 25 2000 Existing System Inspection by: date

HEALTH DEPT. COPY: WHITE OWNER COPY (FINAL): YELLOW OWNER COPY (INITIAL): PINK