IREDELL COUNTY HEALTH DEPARTMENT

Statesville Phone TR 3-7271 Mooresville Phone NO 3-1271

PERMIT TO INSTALL SEPTIC TANK

Permit No. 139 Permit Date 3-14 1972

Owner MISS MARIANNA NICHOLSON Address STATESVILLE, NC

Installed By SAM STEWALT Address TROUTMAN, NC


Location of Property TROUTMAN - PERTH Church Rd - Turn Right on State Park Rd. Then LEFT on Rd. #1321 - Then Right on Rd #1434 House on RH.

Tank		Capacity		Length of Lines		Fixtures	
Block	( )	1000	(✓)	225'	(✓)	No. of Baths	(1)
Precast	(✓)	1250	( )	250'	( )	Dishwasher	( )
		1500	( )	Other		Garbage Grdr.	( )
		Other				Other	

NOTIFY HEALTH DEPARTMENT AT LEAST EIGHT HOURS BEFORE TANK IS TO BE INSPECTED.

Final Inspection 3-14 1972 Approved (✓) Disapproved ( )

Remarks

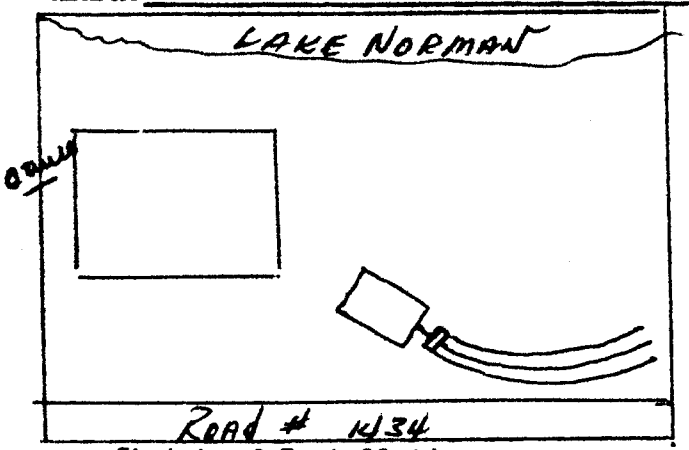

Sketch of Installation

Glenn Todd

Sanitarian