# IREDELL COUNTY HEALTH DEPARTMENT

Statesville Office (704) 878-5305 Mooresville Office (704) 660-3625 PERMIT # 208105

## IMPROVEMENT PERMIT / AUTHORIZATION TO CONSTRUCT / OPERATION PERMIT / EXISTING SYSTEM

PIN # 4629615603

APPLICANT: Samuel Scott APPLICANT ADDRESS: 2278 S. Chipley Ford Rd

SITE ADDRESS: 150 Penicillin Pt Troutman NC PHONE: 704-902-3230 ALT. PHONE: 704-929-8203

SITE DIRECTIONS: Morrison Farm Rd T/R Penicillin Pt House on right

SUBDIVISION: Crescent land + timber SECTION: 517 LOT # 118 LOT AREA: .63ac DESIGN FLOW: Ex L.T.A.R.: Ex

Septic Tank Ex (gal) STB Date
Pump Tank (gal) PT Date
Pump Make Model Serial #
# Nitrification Fields Ex # Lines EX Linear Ft: Ex
Trench Width Ex Max. Trench Bottom Depth Ex Gravel Depth Ex

☐ New System ☐ Repair ☐ Expansion System Type: I II III IV V VI
System Description: Existing
Repair System Description:
Maintenance Agreement Required: ☐ YES ☒ NO
☒ GRAVITY ☐ PRESSURE


☒ Residence No. Bedrooms Ex
☐ Business No. Persons Ex
☐ Other No. Employees
☐ Slab ☐ Crawl Space
☒ Basement w/plumbing ☐ Basement w/o plumbing

Water Supply: ☒ Private ☐ Public ☐ Community

Comments / Conditions: All building foundations and post must be 55' from any part of STS and 525' from any well

INITIAL SITE SKETCH

AS BUILT SKETCH

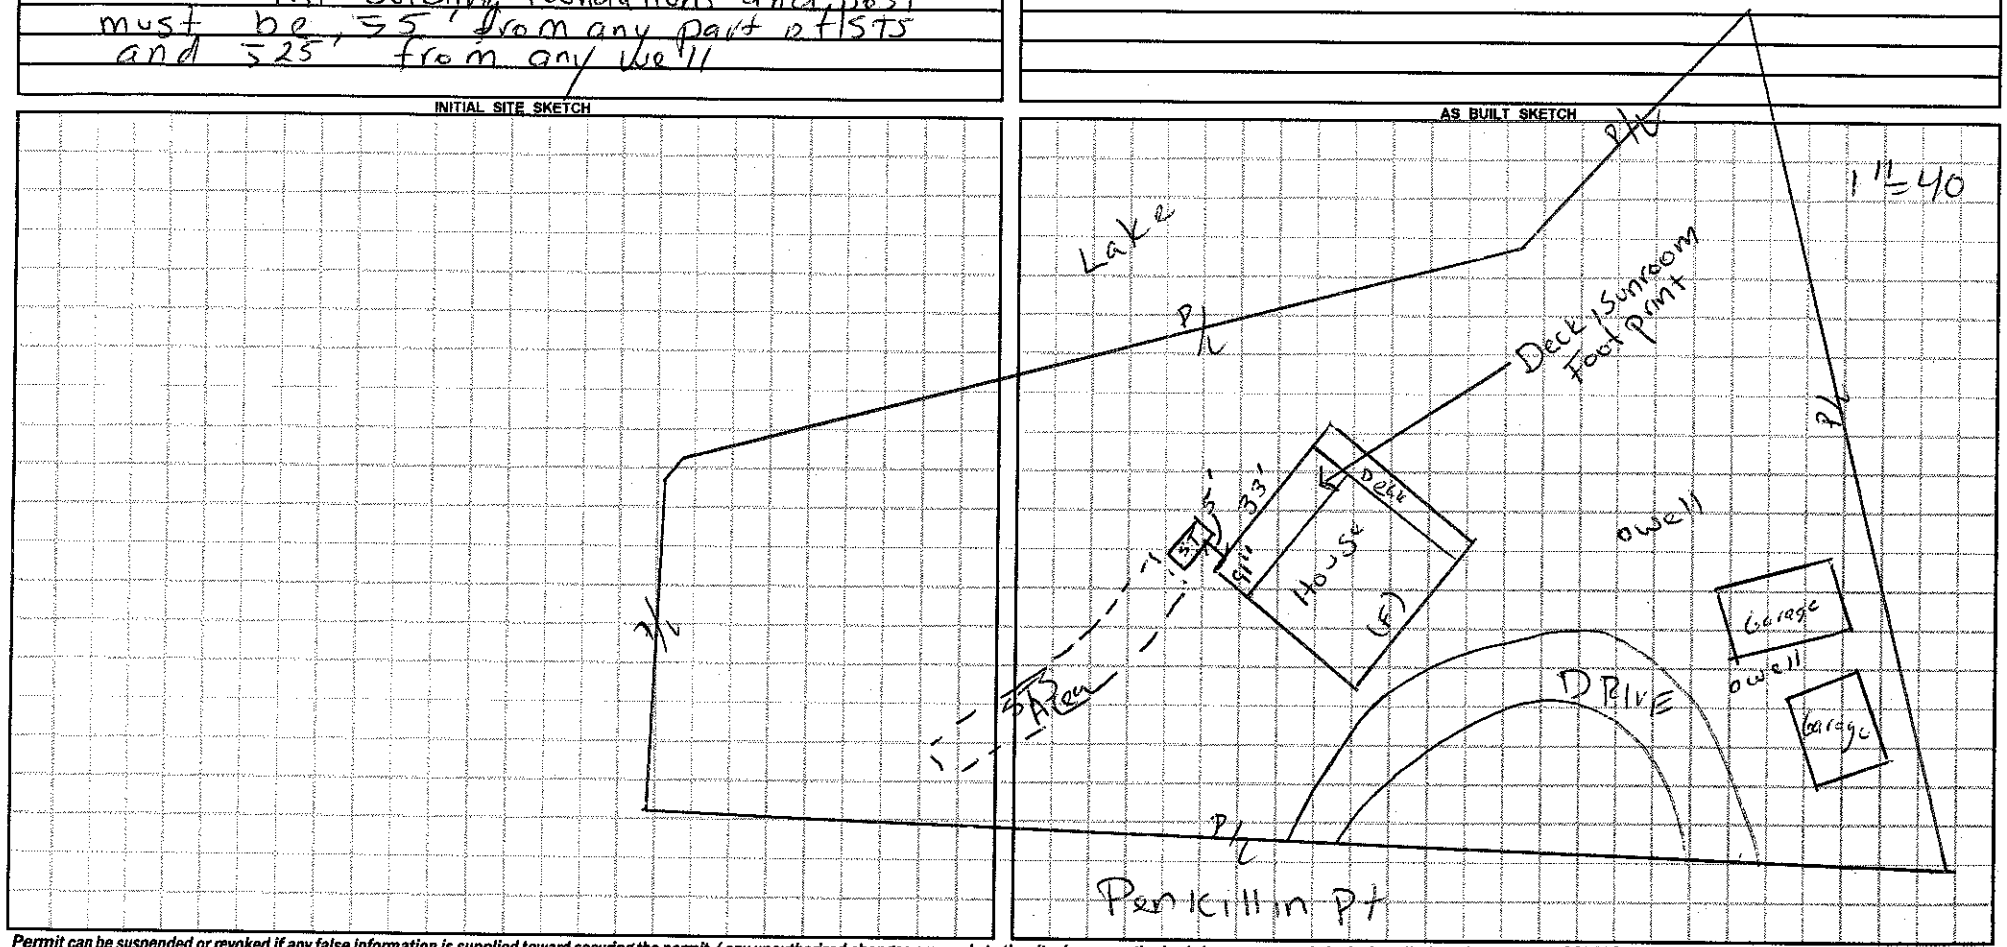


*Permit can be suspended or revoked if any false information is supplied toward securing the permit / any unauthorized changes are made to the site / any unauthorized changes are made in the installation of the system.* **CONTACT A LOCATOR SERVICE PRIOR TO ANY EXCAVATION**

☐ **IMPROVEMENT PERMIT** *with plat valid without expiration.* ☐ **IMPROVEMENT PERMIT** *with site plan valid for 60 mos.* ☐ **AUTHORIZATION TO CONSTRUCT** *valid for period equal to IMPROVEMENT PERMIT--not to exceed 60 mo.*

Owner / Applicant Signature: Samuel A Scott Date: 2-4-15 Installed by:

IMPROVEMENT PERMIT by: Date: OPERATION PERMIT by: Date:

AUTHORIZATION TO CONSTRUCT by: Date: Existing System Inspected by: Robert A Lowe Date: 02/04/15

Health Dept. Copy - WHITE Applicant (Final Approval) - YELLOW Applicant (Conditional Approval) - PINK