IREDELL COUNTY HEALTH DEPARTMENT

STATESVILLE 704-878-5305 MOORESVILLE 704-664-5281

IMPROVEMENT PERMIT / AUTHORIZATION TO CONSTRUCT / OPERATION PERMIT / EXISTING SYSTEM INSPECTION

PERMIT# REPAIR PIN# 4629-61-6585 DATE 7-26-04

OWNER OR CONTRACTOR DAVID REX HAUGHTON PHONE: Business 704-902-2176 Home 704-528-0877

ADDRESS 147 PENICILLIN POINT TROUTMAN NC 28166

LOCATION US 21 S, TR PERTH, TR STATE PARK, TL MORRISON FARM, TR PENICILLIN POINT, 4TH HOUSE ON LEFT

SUBDIVISION DUKE BLOCK / SECTION 17 LOT 126 LOT AREA 0.58 ACRE SITE CLASS. PS DESIGN FLOW 480' L.T.A.R. EXISTING

Septic Tank: EXISTING Gallons; STB ____ Date ____

Pump Tank: ____ Gallons; PT ____ Date ____

Pump Make: ____ Model ____ Serial No. ____

Nitrification Field: No Fields 1 Square Feet 400 Linear Feet 100

No Lines ONE Trench Width 36" Max Trench Bottom Depth 36"

☐ New System ☑ Repair System Type: I, II, (III), IV, V, VI

System Description: ____

Repair System Description: 25% REDUCTION, GRAVITY

Maintenance Agreement Required: ☐ Yes ☑ No

Gravel Depth NA

☑ House/Mod. Home ☐ Mobile Home ☐ Business ☐ Other

No. Bedrooms 4 No. Bathrooms 4 No. Employees ____

☐ Slab ☑ Crawl Space ☐ Basement w/plumbing ☐ Basement wo/plumbing


Water Supply: ☑ Individual ☐ Public ☐ Community

Comments:/Conditions: STEP-UP INTO NEW 25% REDUCTION DRAINLINE AS FLAGGED, NO DEEPER THAN 36", INTERCEPTING EXISTING LINE. KEEP MINIMUM 50' FROM LAKE.

Comments:/Conditions:

~ SCALE: 1" = 60'

INITIAL SITE SKETCH

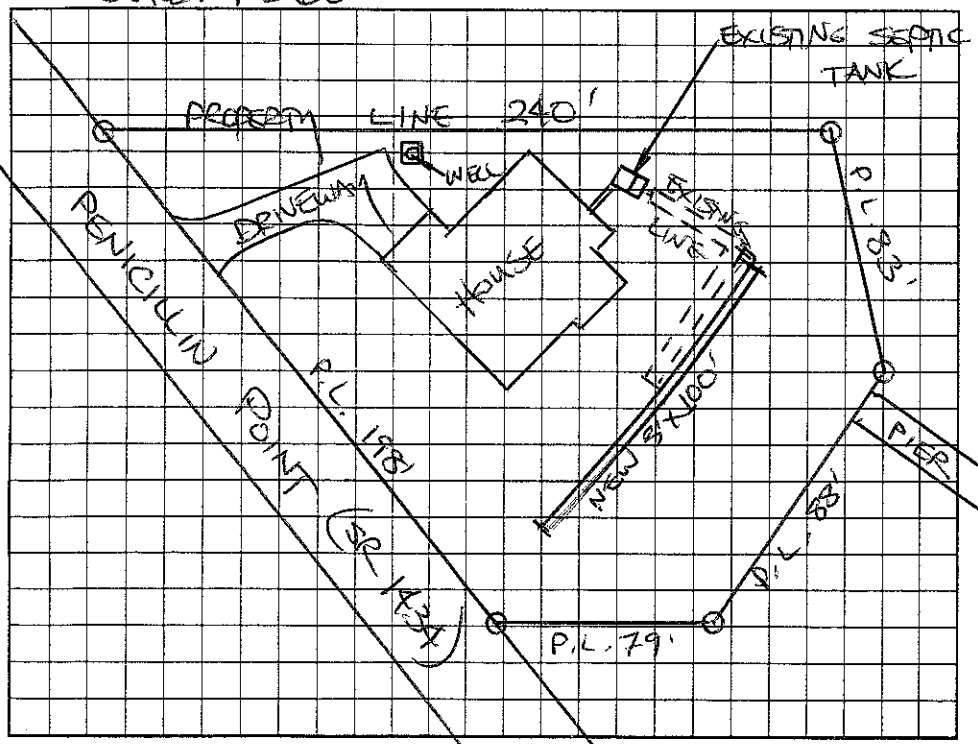

AS BUILT SKETCH

SYSTEM REPAIRED ACCORDING TO INITIAL SITE SKETCH

Permit can be suspended or revoked if any false information is supplied toward securing the permit/any unauthorized changes are made to the site/any unauthorized changes are made in the installation of the system. Improvement Permit with plat valid without expiration. Improvement Permit with site plan valid for sixty months. Authorization to Construct is valid for a period equal to that of Improvement Permit – not to exceed sixty months.

Signed: D. Rex Haughton date 7/26/04 Installed by: PIEDMONT BACKHOE

Improvement Permit by: STEVE HEDRICK date 7-26-04 Operation Permit by: STEVE HEDRICK date 8-31-04

Authorization to Construct by: STEVE HEDRICK date 7-26-04 Existing System Inspection by: ____ date ____

HEALTH DEPT. COPY: WHITE OWNER COPY (FINAL): YELLOW OWNER COPY (INITIAL): PINK