IREDELL COUNTY HEALTH DEPARTMENT

THIS PERMIT VOIDS PREVIOUS ISSUED 4-23-03

STATESVILLE 704-878-5305 (CI) MOORESVILLE 704-664-5281

IMPROVEMENT PERMIT / AUTHORIZATION TO CONSTRUCT / OPERATION PERMIT / EXISTING SYSTEM INSPECTION

PERMIT# 109193 PIN# 4629-61-7956 DATE 9-27-03

OWNER OR CONTRACTOR STEVE COTTON PHONE: Business 704-756-2912 Home 704-658-0562

ADDRESS 175 CARRIAGE CLUB DR, APT 1-201, MOORESVILLE NC 28117

LOCATION US 21 S, TR PERTH RD, TR STATE PARK RD, TL MORRISON FARM RD, TR PENICILLIN PL, TR KEVEN DR, 3RD LOT ON (L)

SUBDIVISION C L & T BLOCK / SECTION 17 LOT 849 LOT AREA 1.35 ACRES SITE CLASS. PS DESIGN FLOW 360 L.T.A.R. 0.30 GPD/FT²

Septic Tank: 1000 Gallons; STB 83 Date 8-8-03
Pump Tank: ____ Gallons; PT ____ Date ____
Pump Make: ____ Model ____ Serial No. ____
Nitrification Field: No Fields 1 Square Feet Eq. Ft 1200 Linear Feet 200
No Lines FOUR Trench Width 24" Max Trench Bottom Depth 36" Gravel Depth SAND 24"

☑ New System ☐ Repair System Type: I, II, (III) IV, V, VI
System Description: 50% REDUCTION, GRAVITY
Repair System Description: 50% REDUCTION, GRAVITY
Maintenance Agreement Required: ☐ Yes ☑ No


☑ House/Mod. Home No. Bedrooms 3
☐ Mobile Home No. Bathrooms 2.5
☐ Business No. Employees ____
☐ Other ____
☐ Slab ☑ Crawl Space ☐ Basement w/plumbing ☐ Basement wo/plumbing

Water Supply: ☑ Individual ☐ Public ☐ Community
WELL


Comments:/Conditions: (1) INSTALL 50% REDUCTION SYSTEM USING 48 PPBPS PANELS IN FOUR EQUAL LENGTH LINES ON CONTOUR (2) USE THREE FLOW DIVIDER TEES TO ACHIEVE EQUAL DISTRIBUTION INTO EACH OF FOUR LINES

Comments:/Conditions:
- poly lok filter Installed

INITIAL SITE SKETCH

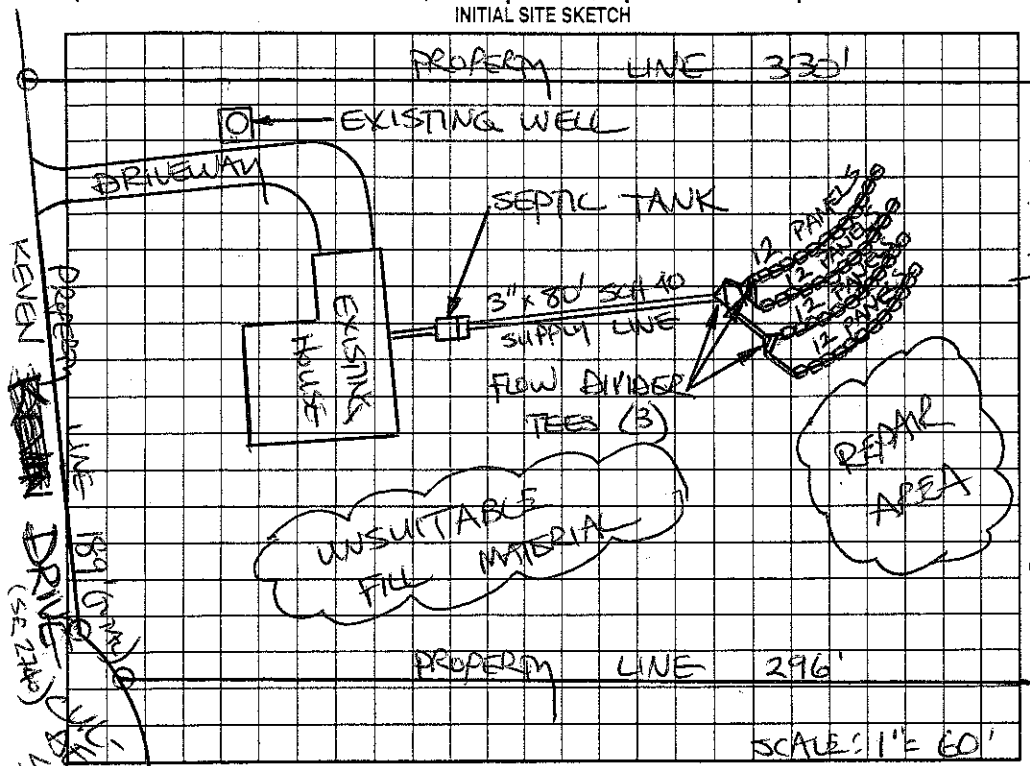

AS BUILT SKETCH

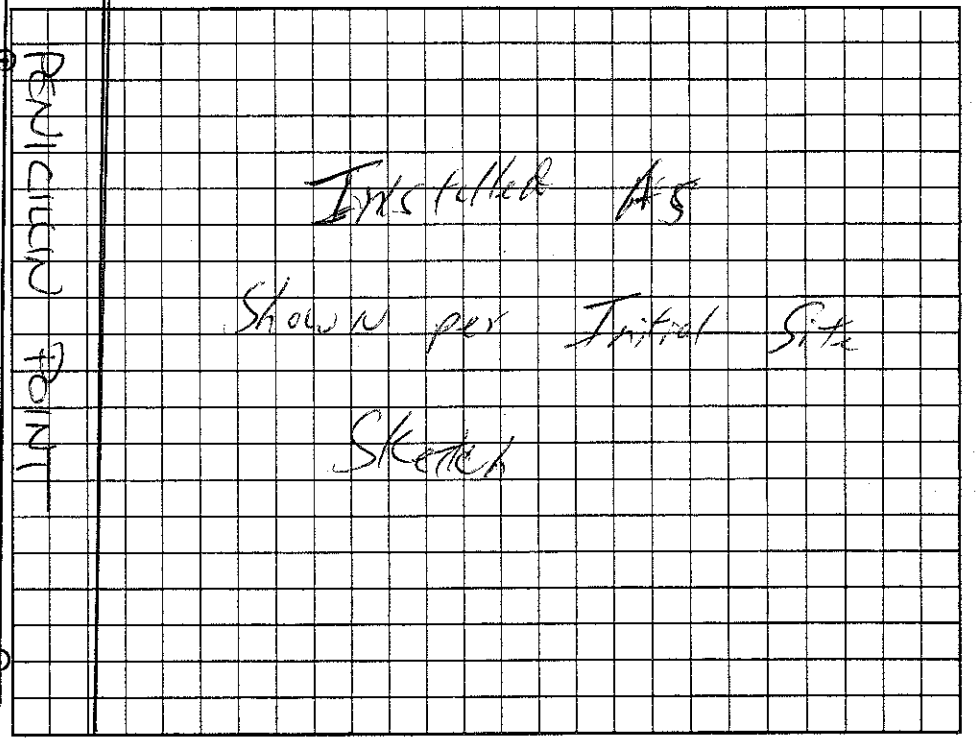

Permit can be suspended or revoked if any false information is supplied toward securing the permit/any unauthorized changes are made to the site/any unauthorized changes are made in the installation of the system. Improvement Permit with plat valid without expiration. Improvement Permit with site plan valid for sixty months. Authorization to Construct is valid for a period equal to that of Improvement Permit – not to exceed sixty months.

Signed: Steve Cotton date 9/29/03 Installed by: Rowan Septic & Grading

Improvement Permit by: STEVE HEDRICK date 9-27-03 Operation Permit by: William O. Job date 10/16/03

Authorization to Construct by: STEVE HEDRICK date 9-27-03 Existing System Inspection by: ____ date ____

HEALTH DEPT. COPY: WHITE OWNER COPY (FINAL): YELLOW OWNER COPY (INITIAL): PINK