IREDELL COUNTY HEALTH DEPARTMENT

STATESVILLE 704-878-5305
MOORESVILLE 704-664-5281

Delbert Boston 1st Thru Friday

IMPROVEMENT PERMIT / CERTIFICATE OF COMPLETION / OPERATION PERMIT / EXISTING SYSTEM INSPECTION

PROPERTY DESCRIPTION NO. 66114 DATE 5-13-97 TAX MAP NO. 4629 61 8642 Watershed: ☑ Yes ☐ No

OWNER OR CONTRACTOR John Ramsey PHONE: Business Home 7044789140

ADDRESS 7474 match point Sherrills Ford, NC

LOCATION morrison Fm Rd TR pencillin pt on left

SUBDIVISION Lake Norman BLOCK / SECTION 17 LOT 95 & 96 LOT AREA 1.69 acres SITE CLASS. PS DESIGN FLOW 240 L.T.A.R. .78

Septic Tank: 1000 Gallons; STB 825 Date 9-15-97

Pump Tank: ____ Gallons; PT ____ Date ____

Pump Make: ____ Model ____ Serial No. ____

Nitrification Field: No Fields 1 Square Feet 900 Linear Feet 300

No Lines 4 Trench Width 36" Max Trench Bottom Depth 36" Gravel Depth ____

☐ New System ☐ Repair System Type: I ☑ II, III, IV, V, VI

System Description: conv. Gravity

Repair System Description: Pump To Chambers

Maintenance Agreement Required: ☐ Yes ☐ No

☐ House/Mod. Home No. Bedrooms 2
☐ Mobile Home No. Bathrooms 2
☐ Business No. Employees ____
☐ Other ____


☐ Slab ☐ Crawl Space ☑ Basement w/plumbing ☐ Basement wo/plumbing

Water Supply: ☑ Individual ☐ Community ☐ Public


Comments:

Comments:

INITIAL SITE SKETCH

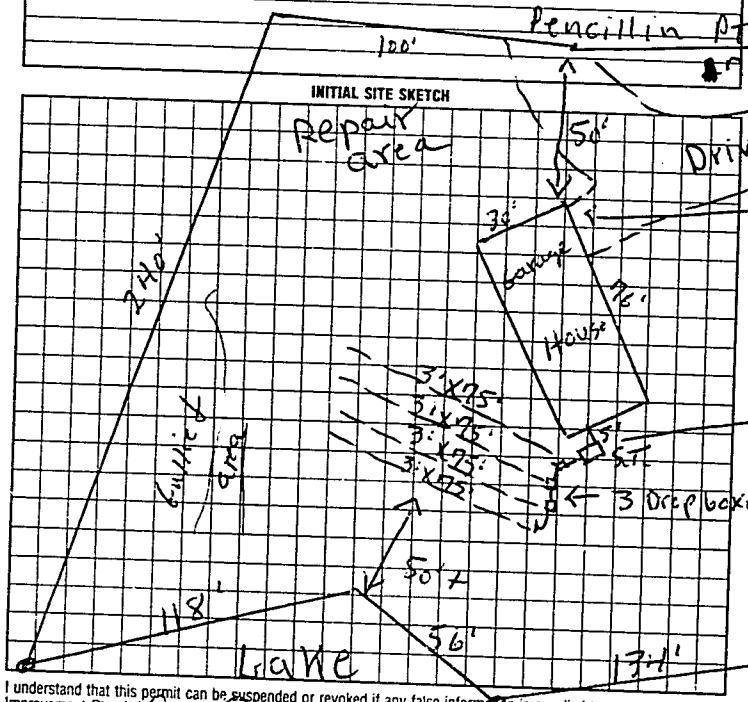

AS BUILT SKETCH

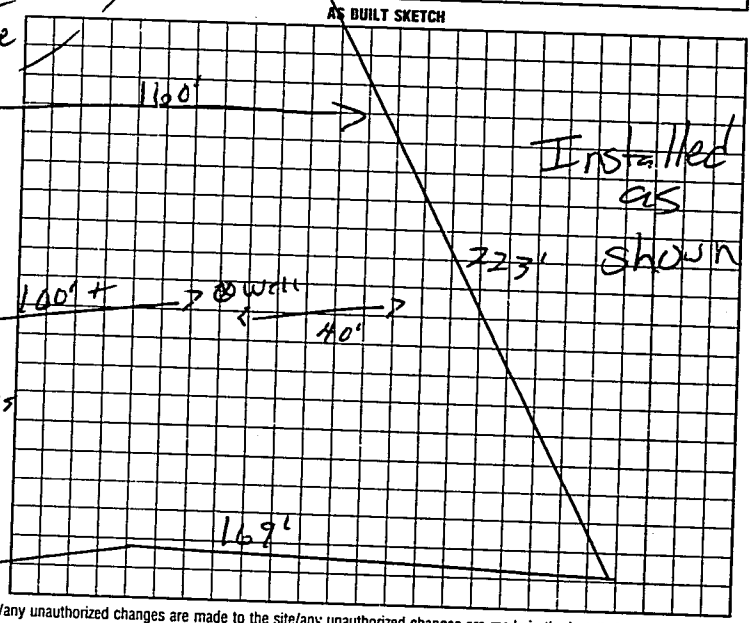

I understand that this permit can be suspended or revoked if any false information is supplied toward securing the permit/any unauthorized changes are made to the site/any unauthorized changes are made in the installation of the system. Improvement Permit is valid for 60 months from date of issuance.

Signed: John Ramsey

Improvement Permit by: P.C. Moore date 5-13-97

Authorization to Cover by: P.C. Moore date 5-13-97

Installed by: Delbert Boston

Certificate of Completion by: ____ date ____

Operation Permit by: MaryC O'Jones date 11-25-97

HEALTH DEPT COPY: WHITE INSPECTION COPY (FINAL): GREEN OWNER COPY (FINAL): YELLOW INSPECTION COPY (INITIAL): PINK OWNER COPY (INITIAL): BLUE

Authorization to Cover Expires 6 months from issue