IREDELL COUNTY HEALTH DEPARTMENT

STATESVILLE 704-878-5305 MOORESVILLE 704-664-5281

IMPROVEMENT PERMIT / AUTHORIZATION TO CONSTRUCT / OPERATION PERMIT / EXISTING SYSTEM INSPECTION

PERMIT# REPAIR PIN# 4629-62-0736 DATE 01/13/03

OWNER OR CONTRACTOR GEORGE THOMAS WILSON PHONE: Business Home 704-528-6298

ADDRESS 151 WINDWOOD LN. TROUTMAN, NC 28166

LOCATION PERTH RD. (R) STATE PARK RD. (L) MORRISON FARM RD., (R) APRIL RD., (L) WINDWOOD LN., (L) THERON PLACE, LOT ON LEFT ON CORNER

SUBDIVISION [redacted] CL&T BLOCK / SECTION (17) LOT 99 LOT AREA 1.17 ACRES SITE CLASS. REPAIR DESIGN FLOW 360 GPD L.T.A.R. REPAIR

Septic Tank: EXISTING Gallons; STB [redacted] Date [redacted]
Pump Tank: 1,000 Gallons; PT 17 Date 01/08/02
Pump Make: GOULDS Model #02399328 Serial No. WE0511H
Nitrification Field: No Fields 1 Square Feet EQ to 900 Linear Feet 150
No Lines 5@30' Trench Width 24" Max Trench Bottom Depth 40" Gravel Depth N/A

☐ New System ☒ Repair System Type: I, II, (III), IV, V, VI
System Description: PUMP, 50% REDUCTION
Repair System Description:
Maintenance Agreement Required: ☐ Yes ☒ No


House/Mod. Home No. Bedrooms 3
☒ Mobile Home No. Bathrooms 2
☐ Business No. Employees
☐ Other EXISTING

☐ Slab ☒ Crawl Space ☐ Basement w/plumbing ☐ Basement wo/plumbing


Water Supply: ☒ Individual ☐ Public ☐ Community EXISTING WELL

Comments/Conditions: (1) INSTALL SYSTEM USING 7 PANELS PER LINE (35 PANELS TOTAL) (2) SEE ATTACHED SHEETS FOR PUMP & PRESSURE MANIFOLD INFO. (3) CREATE SURFACE DIVERSION DITCH ABOVE SYSTEM TO DIVERT SURFACE WATER, (4) CALL AFTER CLEARING IF REFLAGGING IS NEEDED. (5) ABANDON OLD SEPTIC DRAIN FIELD. (6) LINES CAN GO AS CLOSE AS 5' FROM PROPERTY LINE.

INITIAL SITE SKETCH

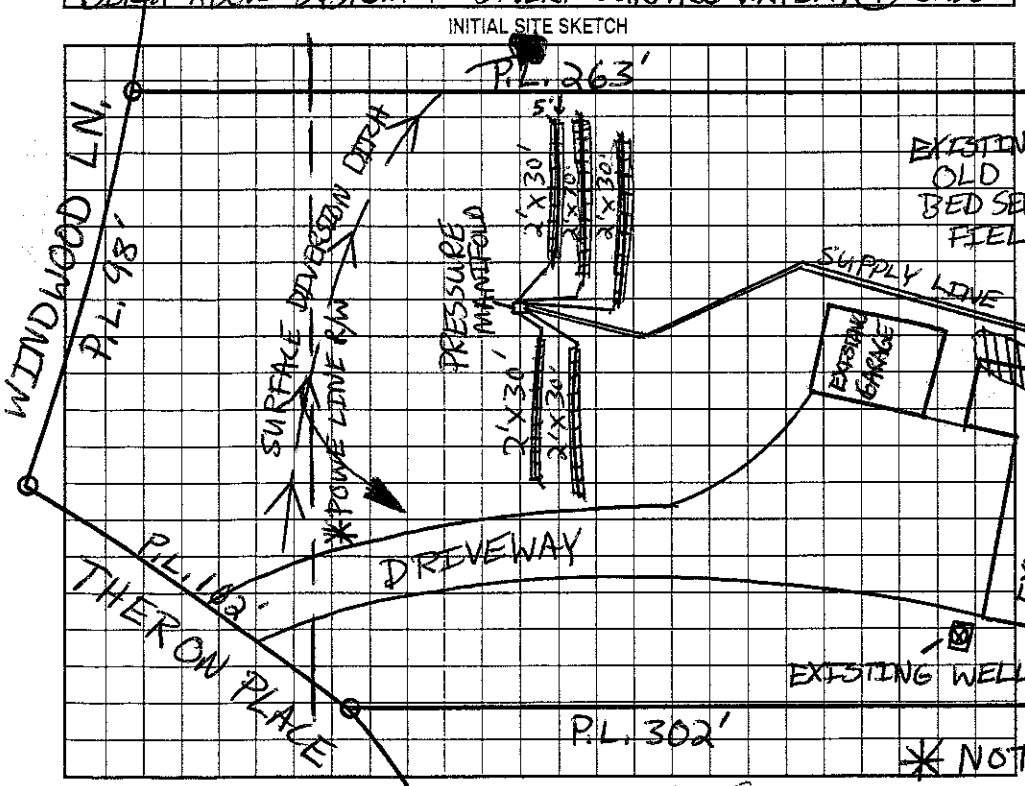

AS BUILT SKETCH

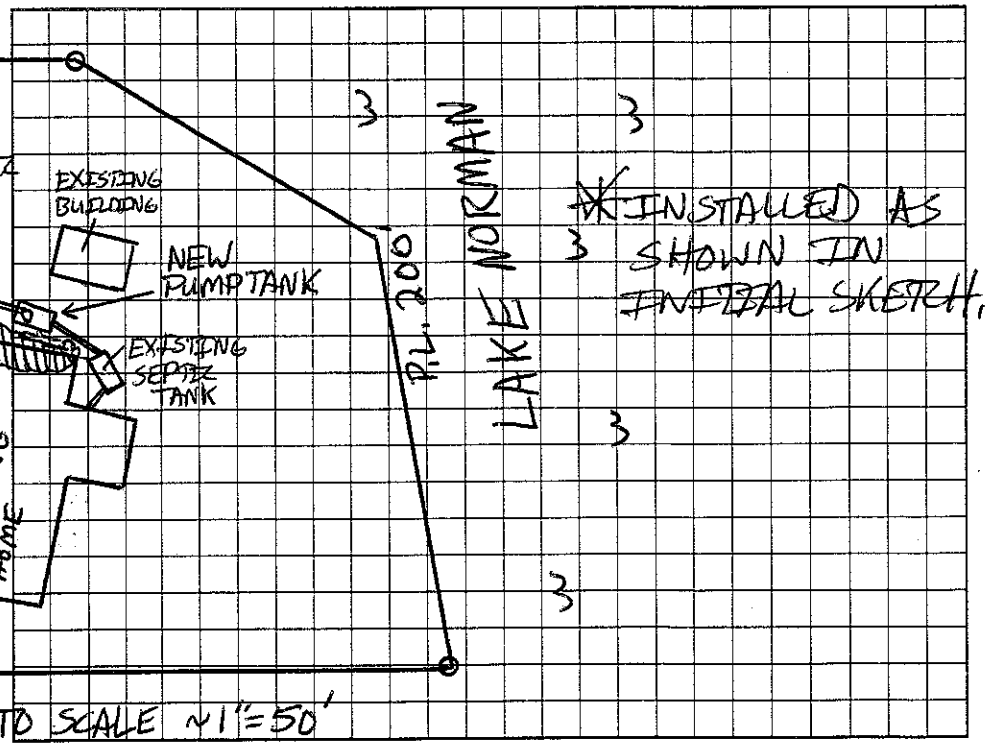

Permit can be suspended or revoked if any false information is supplied toward securing the permit/any unauthorized changes are made to the site/any unauthorized changes are made in the installation of the system. Improvement Permit with plat valid without expiration. Improvement Permit with site plan valid for sixty months. Authorization to Construct is valid for a period equal to that of Improvement Permit – not to exceed sixty months.

Signed: George Thomas Wilson date 01/13/03 Installed by: STEVE JORDAN 04/03/03

Improvement Permit by: Patrick Mitchell date 01/13/03 Operation Permit by: Patrick Mitchell date 04/04/03

Authorization to Construct by: Patrick Mitchell date 01/13/03 Existing System Inspection by: date

HEALTH DEPT. COPY: WHITE OWNER COPY (FINAL): YELLOW OWNER COPY (INITIAL): PINK