IREDELL COUNTY HEALTH DEPARTMENT

Statesville Phone TR 3-7271 Mooresville Phone NO 3-1271

PERMIT TO INSTALL SEPTIC TANK

Permit NO. 346 Permit Date Oct 6 1970

Owner WILSON Address ELKIN, N.C

Installed By SAM OSTWALT Address TROUTMAN, N.C.


Location of Property State Park Road - Toward Morrison Point - Turn Right on Road at 601 - Turn Left on 2nd Road - on Left 2nd Driveway.

Tank		Capacity		Length of Lines		Fixtures	
Block	( )	1000	( )	225'	( )	No. of Baths	(1)
Precast	( )	1250	( )	250'	( )	Dishwasher	( )
		1500	( )	Other 110		Garbage Grdr.	( )
		Other		Extra Tufflite		Other	

NOTIFY HEALTH DEPARTMENT AT LEAST EIGHT HOURS BEFORE TANK IS TO BE INSPECTED.

Final Inspection Oct 6 1970 Approved (4) Disapproved ( )

Remarks

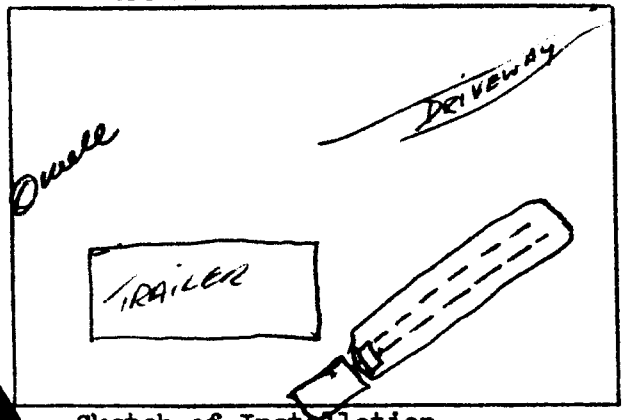

Sketch of Installation

Glenn Lough

Sanitarian