IREDELL COUNTY HEALTH DEPARTMENT

STATESVILLE 704-878-5305 MOORESVILLE 704-664-5281

IMPROVEMENT PERMIT / AUTHORIZATION TO CONSTRUCT / OPERATION PERMIT / EXISTING SYSTEM INSPECTION

PERMIT# 120232 PIN# 4629-62-1837 CELL# 704-467-3536 DATE 6-29-04

OWNER OR CONTRACTOR RANDY & JUDY MORGAN PHONE: Business 704-723-6030 Home 704 947-9900

ADDRESS 13216 FREMINGTON RD HUNTERSVILLE, NC 28078

LOCATION MORRISON FARM RD (R) APRIL (L) WINDWOOD LOT 98 ON LEFT

SUBDIVISION CL&T BLOCK / SECTION 17 LOT 98 LOT AREA 1.07 AC SITE CLASS. PS DESIGN FLOW 360 L.T.A.R. .3

Septic Tank: 1000 Gallons; STB 1012 Date 1-1-06
Pump Tank: 1000 Gallons; PT 17 Date 8-1-06
Pump Make: GOULDS Model WE0712HH Serial No.
Nitrification Field: No Fields 1 Square Feet EQ=1200 Linear Feet 200'
No Lines 4X50' Trench Width 24" Max Trench Bottom Depth 36" Gravel Depth N/A

☒ New System ☐ Repair System Type: I, II, (III), IV, V, VI
System Description: PUMP [redacted] 50% REPAIR
Repair System Description: LP PANEL
Maintenance Agreement Required: ☐ Yes ☒ No

☒ House/Mod. Home No. Bedrooms 3
☐ Mobile Home No. Bathrooms 2
☐ Business No. Employees
☐ Other


☐ Slab ☐ Crawl Space ☒ Basement w/plumbing ☐ Basement wo/plumbing

Water Supply: ☒ Individual ☐ Public ☐ Community

Comments:/Conditions: (1) KEEP BASEMENT HIGH ENOUGH TO MAINTAIN FALL TO TANKS (2) FILL & DIRECT DRAINAGE WAY & STAY 5' OFF OR MORE (3) KEEP SUPPLY 10' OFF BASEMENT & 5' OFF P/L (4) ABANDON OLD SEPTIC SYSTEM

Comments:/Conditions: WHEN READY. IF ANY GRAVEL IS DUG OUT DURING BUILDING. DISPOSE OF IT PROPERLY (5) INSTALL LINES ON CONTOURS & MAINTAIN SETBACKS (6) CALL PRIOR TO INSTALLATION FOR PUMP SIZING & SPECS IF NEEDED. (7) CABIN IS ON LOT NOW & WILL BE MOVED WHEN HOUSE IS BUILT.

INITIAL SITE SKETCH 1"=40" AS BUILT SKETCH

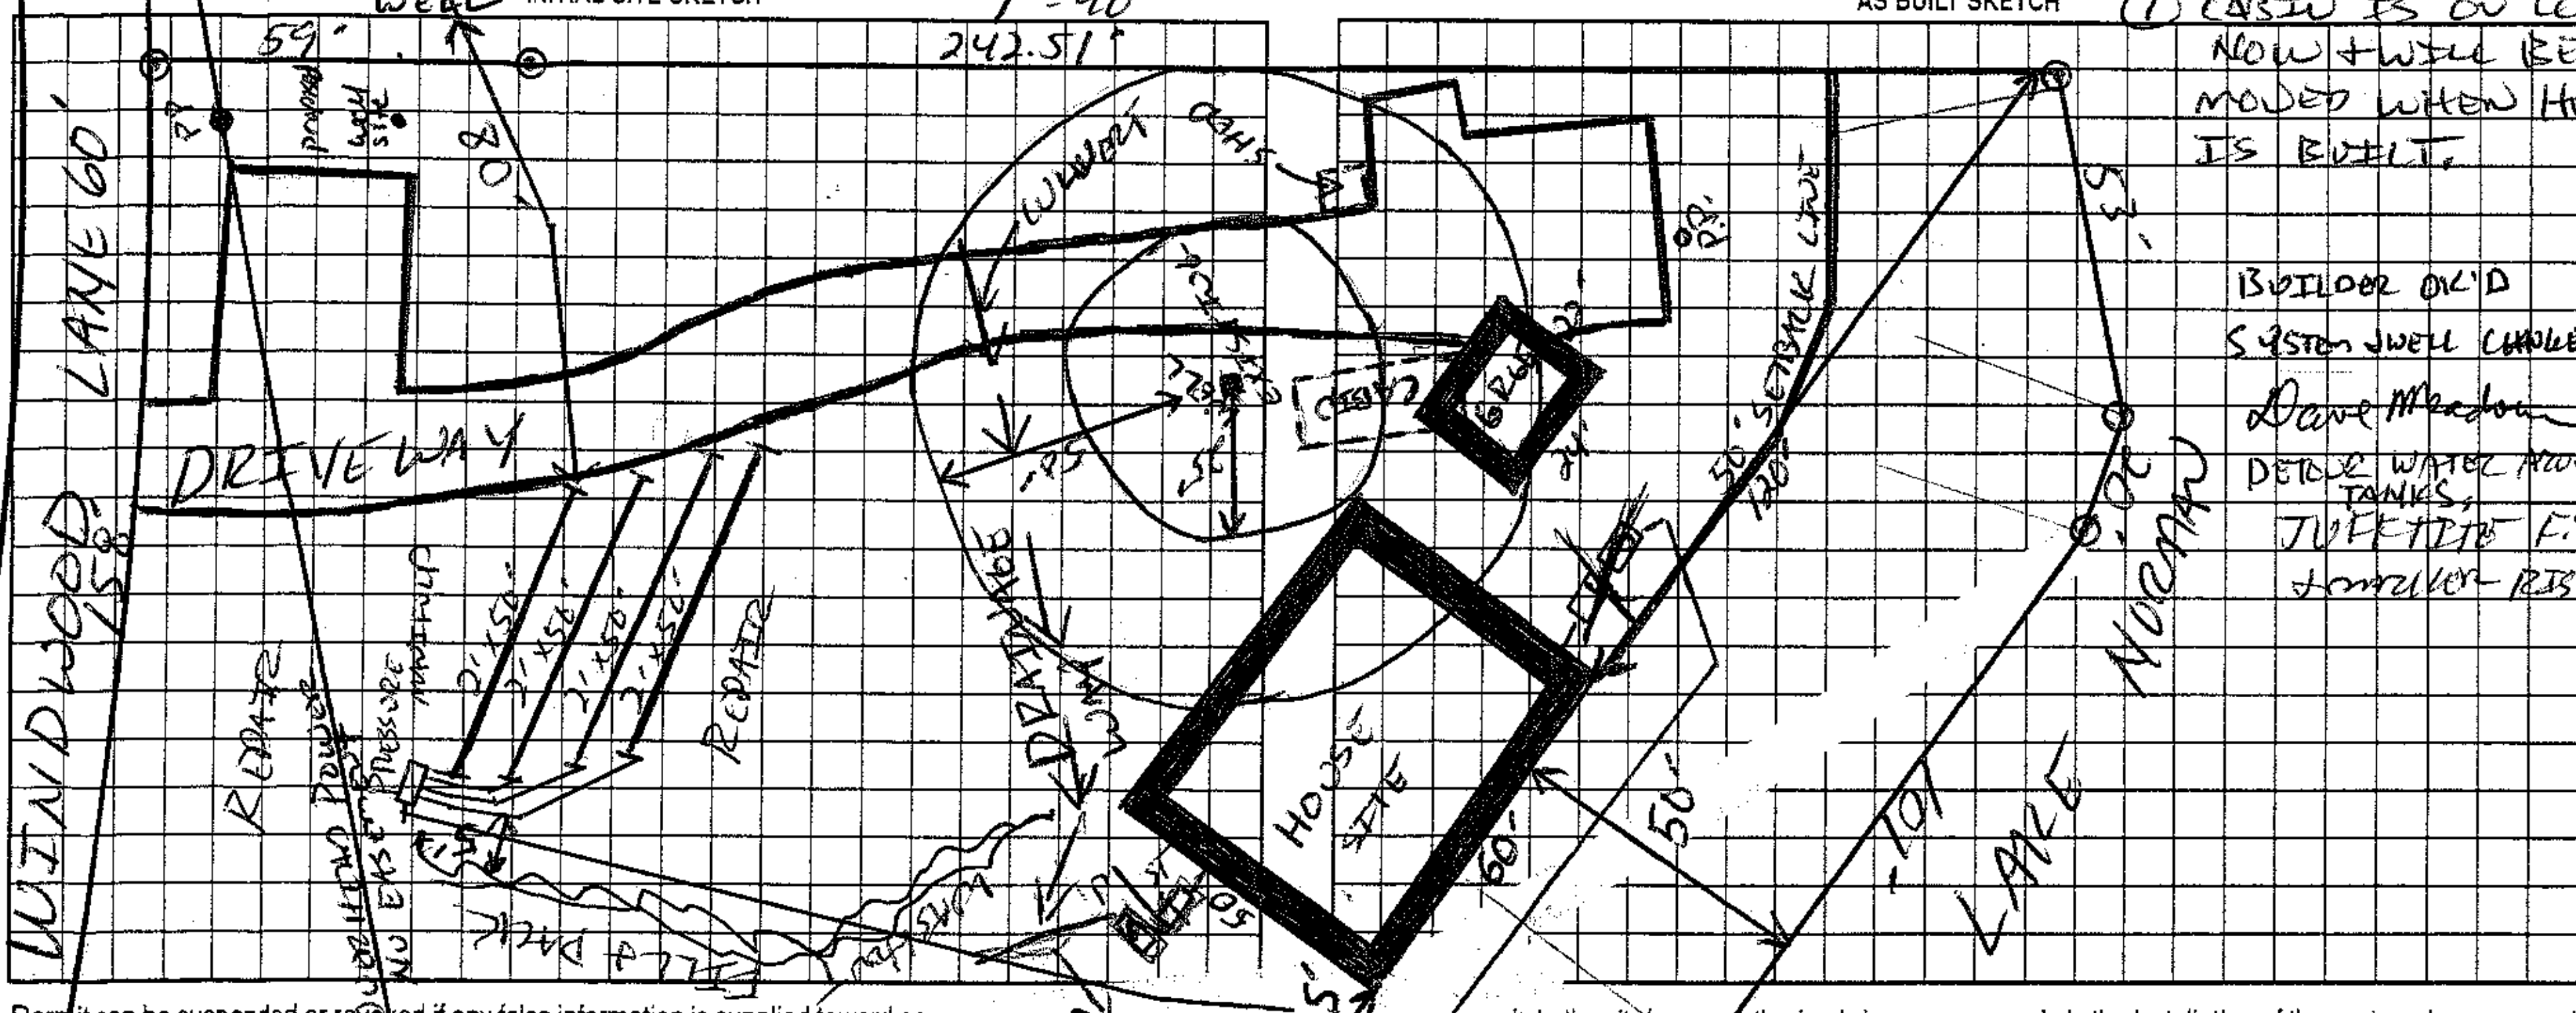

Permit can be suspended or revoked if any false information is supplied toward ... unauthorized changes are made to the site/any unauthorized changes are made in the installation of the system. Improvement Permit with plat valid without expiration. Improvement Permit wi... for sixty months. Authorization to Construct is valid for a period equal to that of Improvement Permit – not to exceed sixty months.

Signed: Judy Morgan date 8-5.04 Installed by: A-1 BACKHOE

Improvement Permit by: [signature] RS date 6-29-04 Operation Permit by: [signature] RS date 1-4-07

Authorization to Construct by: [signature] RS date 6-29-04 Existing System Inspection by: date

HEALTH DEPT. COPY: WHITE OWNER COPY (FINAL): YELLOW OWNER COPY (INITIAL): PINK