IREDELL COUNTY HEALTH DEPARTMENT

STATESVILLE 704-878-5305 MOORESVILLE 704-664-5281

37150

IMPROVEMENT PERMIT / CERTIFICATE OF COMPLETION / OPERATION PERMIT / EXISTING SYSTEM INSPECTION

PROPERTY DESCRIPTION NO. _____ DATE 8-16-96 TAX MAP NO. _____ Watershed: ☑ Yes ☐ No

OWNER OR CONTRACTOR Dave Heagle PHONE: Business _____ Home 528 3409

ADDRESS 136 Tayport Drive

LOCATION Morrison From Rt 3 TR April Rd 1st Gravel Drive Turn left at end

SUBDIVISION Lake Norman BLOCK / SECTION 17 LOT [redacted] LOT AREA 3/4acre + SITE CLASS. PS DESIGN FLOW _____ L.T.A.R. .4

Septic Tank: Ex. Gallons; STB _____ Date _____

Pump Tank: _____ Gallons; PT _____ Date _____

Pump Make: _____ Model _____ Serial No. _____

Nitrification Field: No Fields 1 Square Feet 600 Linear Feet 200

No Lines 2 Trench Width 36" Max Trench Bottom Depth 36" Gravel Depth ~~12~~ N/A

☐ New System ☑ Repair System Type: I, II, III, IV, V, VI

System Description: Gravity Chambers

Repair System Description: ↓ ↓ ↓ ↓

Maintenance Agreement Required: ☐ Yes ☐ No

☐ House/Mod. Home No. Bedrooms ____

☐ Mobile Home No. Bathrooms ____

☐ Business No. Employees ____

☑ Other _____


☐ Slab ☐ Crawl Space ☑ Basement w/plumbing ☐ Basement wo/plumbing

Water Supply: ☑ Individual ☐ Community ☐ Public


Comments: 2nd option Repair By using 6' X 100' Gravel Bed 2 lines with 18" Stone

Comments:

INITIAL SITE SKETCH

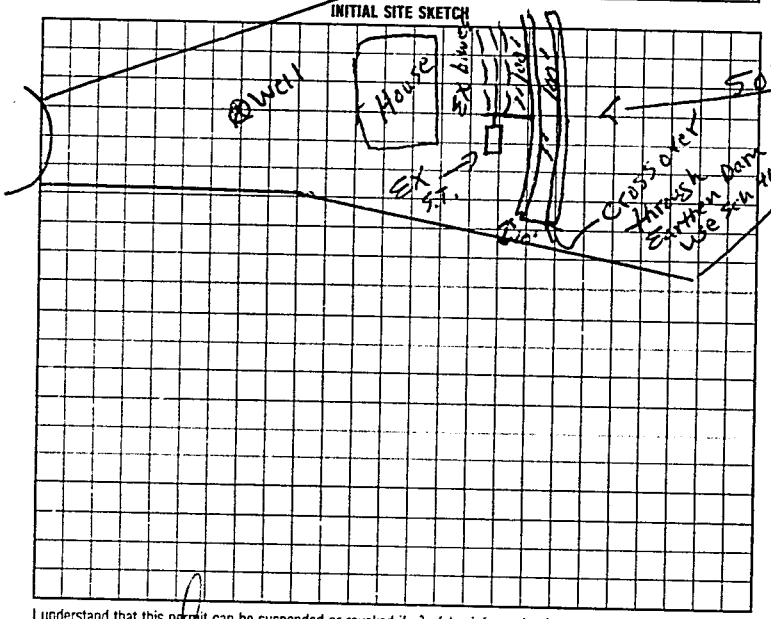

AS BUILT SKETCH

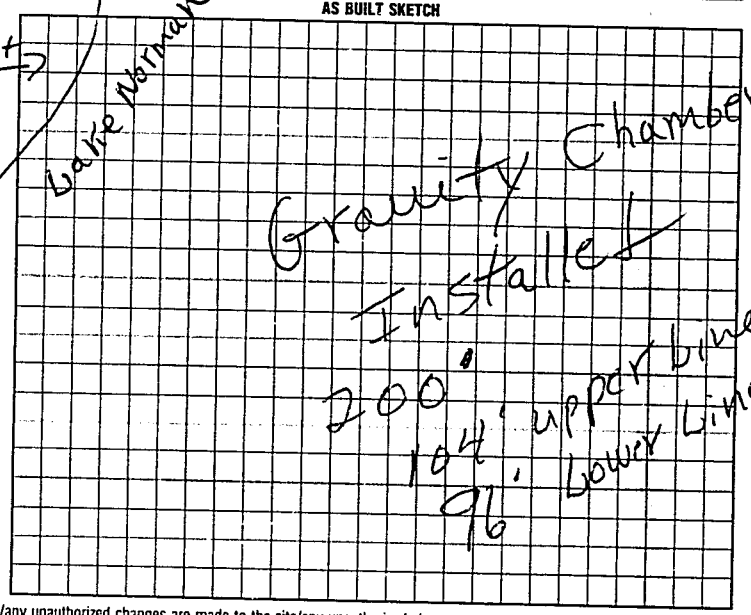

I understand that this permit can be suspended or revoked if any false information is supplied toward securing the permit/any unauthorized changes are made to the site/any unauthorized changes are made in the installation of the system.

Signed: X Talma C. Heagle

Improvement Permit by: R. C. Moore date 8-16-96

Authorization to Construct Existing System Inspection by: R. C. moore date 8-16-96

Installed by: James Hudler

Certificate of Completion by: _____ date _____

Operation Permit by: R. C. moore date 10-15-96

HEALTH DEPT. COPY: WHITE INSPECTION COPY (FINAL): GREEN OWNER COPY (FINAL): YELLOW INSPECTION COPY (INITIAL): PINK OWNER COPY (INITIAL): GOLD

to Const. Authorization to Construct EXPIRES 6 months from issue