37150

IREDELL COUNTY HEALTH DEPARTMENT

STATESVILLE 704-878-5305 MOORESVILLE 704-664-5281

IMPROVEMENT PERMIT / CERTIFICATE OF COMPLETION / OPERATION PERMIT / EXISTING SYSTEM INSPECTION

PROPERTY DESCRIPTION NO DATE 8-16-96 TAX MAP NO Watershed: Lakes ☐ No

OWNER OR CONTRACTOR Dave Ingle PHONE: Business Home 528 3409

ADDRESS 136 Taypoint Drive

LOCATION Morrison 1/2 mi at 9 TR April Rd 1st Gravel Drive Turn left at end

SUBDIVISION Lake Norman BLOCK / SECTION 17 LOT 9 LOT AREA 3/4 ac± SITE CLASS PS DESIGN FLOW L.T.A.R. .4


Septic Tank 2X Gallons STB Date	☐ New System ☐ Repair System Type: I, II, III, IV, V, VI	☐ House/Mod. Home No. Bedrooms
Pump Tank Gallons PT Date	System Description Gravity Chambers	☐ Mobile Home No. Bathrooms
Pump Make Model Serial No.	Repair System Description	☐ Business No. Employees
Nitrification Field No Ft/Ln 1 Square Feet 600 Linear Feet 200	Maintenance Agreement Required: ☐ Yes ☐ No	☐ Other
No Lines 2 Trench Width 36" Max Trench Bottom Depth 36"	Gravel Depth N/A ☐ Slab ☐ Crawl Space ☐ Basement w/plumbing ☐ Basement w/o plumbing	

Water Supply: ☐ Individual ☐ Community ☐ Public


Comments 20% option Repair By using 6'x100' Gravel Bed 2 lines with 18" Stone

Comments

INITIAL SITE SKETCH

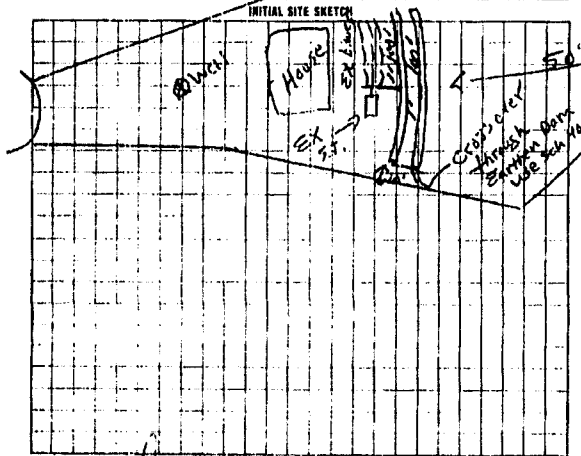

AS BUILT SKETCH

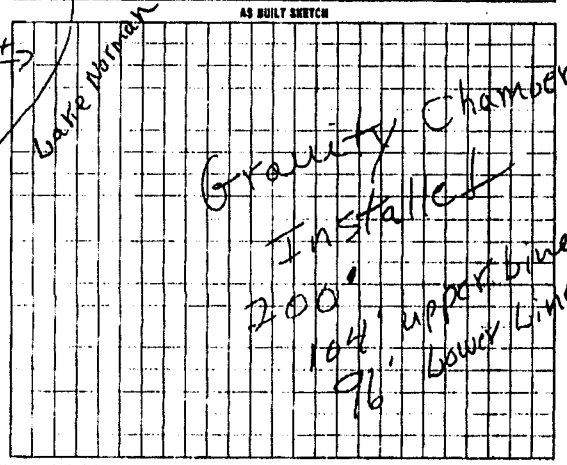

I understand that this permit can be suspended or revoked if any false information is supplied toward securing the permit, any unauthorized changes are made to the site, any unauthorized changes are made in the installation of the system.

Signed X Dave Ingle

Improvement Permit by R.C. Moore date 8-16-96

Authorization To Cover Expires 6 mos from issue

Installed by James Hudler

Certificate of Completion by date

Operation Permit by R.C. Moore date 10-15-96

COUNTY SANITARIAN COPY WHITE HEALTH DEPT COPY WHITE INSPECTION COPY (FINAL) GREEN OWNER COPY (FINAL) YELLOW INSPECTION COPY (INITIAL) PINK OWNER COPY (INITIAL) GOLD

Authorization To Cover Expires 6 mos from issue

JAN. 1, 1989 0:02