IREDELL COUNTY HEALTH DEPARTMENT

STATESVILLE 704-878-5305 MOORESVILLE 704-664-5281

IMPROVEMENT PERMIT / CERTIFICATE OF COMPLETION / OPERATION PERMIT / EXISTING SYSTEM INSPECTION

PROPERTY DESCRIPTION NO. 24055 DATE 7-1-96 TAX MAP NO. 3C-6-A-136 Watershed: ☑ Yes ☐ No

OWNER OR CONTRACTOR Dennis Stanke PHONE: Business 359 1000 Home

ADDRESS 162 morgan Bluff mooresville

LOCATION St Paul RD Turn morrison Rm TR Perrillin PT TR Kevin 2nd lot left

SUBDIVISION Crescent BLOCK / SECTION LOT 348 LOT AREA 1.47 acres SITE CLASS. PS DESIGN FLOW 480 L.T.A.R. .3

Septic Tank: 1000 Gallons; STB Date 5-11-97

Pump Tank: Gallons; PT Date

Pump Make: Model Serial No

Nitrification Field. No Fields 1 Square Feet 1620 Linear Feet 540

No Lines 5 Trench Width 36" Max Trench Bottom Depth 24" Gravel Depth 12"

☑ New System ☐ Repair System Type: I, II, III, IV, V, VI

System Description: Conv. Gravity

Repair System Description: " "

Maintenance Agreement Required: ☐ Yes ☑ No

☑ House/Mod. Home No. Bedrooms 4

☐ Mobile Home No Bathrooms 2½

☐ Business No. Employees

☐ Other


☐ Slab ☑ Crawl Space ☐ Basement w/plumbing ☐ Basement wo/plumbing

Water Supply: ☑ Individual ☐ Community ☐ Public


Comments:

Comments: House Changed to 3Bd

INITIAL SITE SKETCH

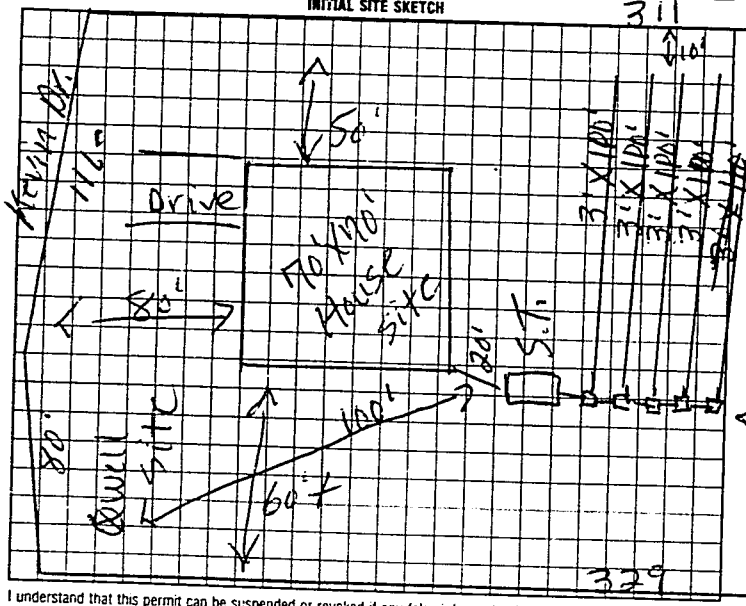

AS BUILT SKETCH

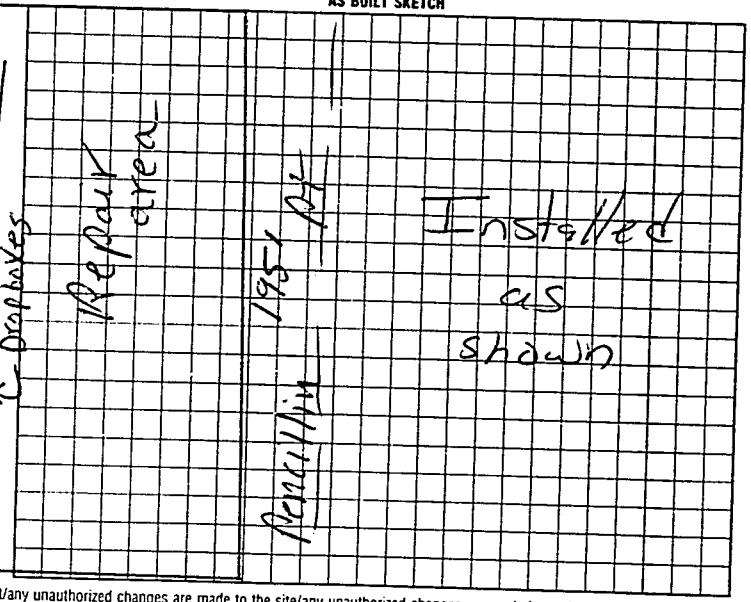

I understand that this permit can be suspended or revoked if any false information is supplied toward securing the permit/any unauthorized changes are made to the site/any unauthorized changes are made in the installation of the system.

Signed: Dennis C Stanke

Improvement Permit by: Author Lost L.C. moore date 7-1-96

Existing System Inspection by: L.C. moore date 7-1-96

Installed by: Delbert Bostian

Certificate of Completion by: date

Operation Permit by: Mary C. Ott RS date 7-18-97

to court. Authorization to court Expires 6 mos from issue

HEALTH DEPT COPY WHITE INSPECTION COPY (FINAL) GREEN OWNER COPY (FINAL) YELLOW INSPECTION COPY (INITIAL) PINK OWNER COPY (INITIAL) GOLD