FAXED 5-11-11 approval

IREDELL COUNTY HEALTH DEPARTMENT

STATESVILLE 704-878-5305 MOORESVILLE 704-664-5281

IMPROVEMENT PERMIT / CERTIFICATE OF COMPLETION / OPERATION PERMIT / EXISTING SYSTEM INSPECTION

PROPERTY DESCRIPTION NO. 24055 DATE 7-1-96 TAX MAP NO. 3C-6-A-136 Watershed: ☐ Yes ☐ No

OWNER OR CONTRACTOR Dennis Stanke PHONE: Business 359 1000 Home WS IV CA

ADDRESS 162 Morgan Bluff Mooresville

LOCATION St Pauls Rd Turn Morrison Fm TR Peralin PT TR Kevin 2nd Lot Left

SUBDIVISION Crescent BLOCK / SECTION LOT 848 LOT AREA 1.149 acres SITE CLASS PS DESIGN FLOW 480 L.T.A.R. 1.3

Septic Tank: 1000 Gallons; STB Date 5-11-97
Pump Tank: Gallons; PT Date
Pump Make: Model Serial No
Nitrification Field. No Fields 1 Square Feet 1620 Linear Feet 540
No Lines 5 Trench Width 36" Max Trench Bottom Depth 24"

☑ New System ☐ Repair System Type: I, II, III, IV, V, VI
System Description: Conv. Gravity
Repair System Description: " "
Maintenance Agreement Required: ☐ Yes ☐ No
Gravel Depth 12" ☐ Slab ☐ Crawl Space ☐ Basement w/plumbing ☐ Basement wo/plumbing


☐ House/Mod. Home No. Bedrooms 4
☐ Mobile Home No Bathrooms 2½
☐ Business No. Employees
☐ Other

Water Supply: ☑ Individual ☐ Community ☐ Public


Comments:

Comments: House Changed to 3Bd

INITIAL SITE SKETCH

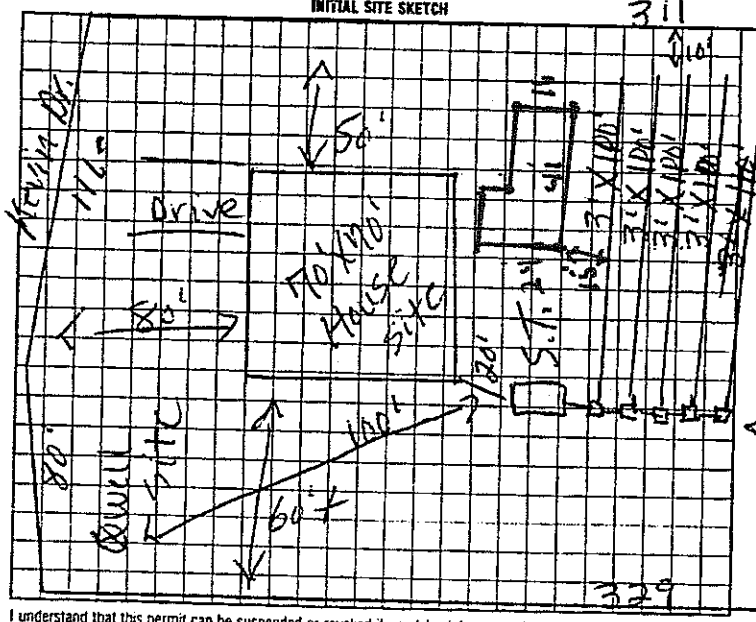

AS BUILT SKETCH

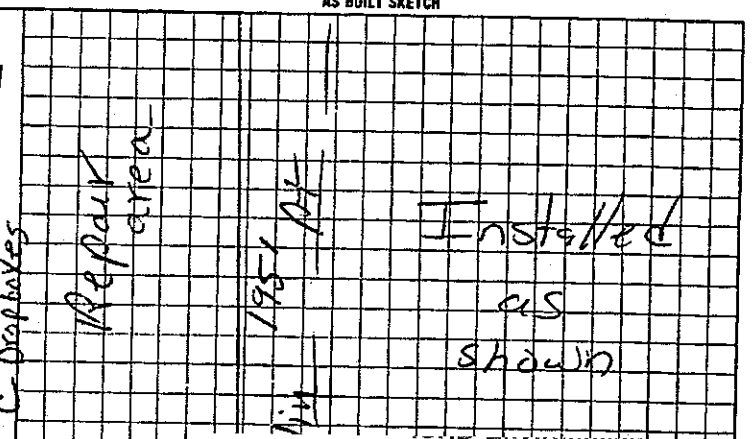

I understand that this permit can be suspended or revoked if any false information is supplied toward securing the permit/any unauthorized changes are s.

Signed: Connie C. Chesser

Improvement Permit by: R.C. Moore date 7-1-96

Existing System Inspection by: R.C. Moore date 7-1-96

Authorization to count.

Installed by: Delbert Bostian

Certificate of Completion by: date

Operation Permit by: Mark C. Oates date 7-18-97

Authorization to count Expires 6 mos from issue

HEALTH DEPT COPY WHITE — INSPECTION COPY (FINAL) GREEN — OWNER COPY (FINAL) YELLOW — INSPECTION COPY (INITIAL) PINK — OWNER COPY (INITIAL) BLUE

Location of the proposed Swimming Pool addition does not appear to impact the existing on-site septic system.**NOTE:

REHS

Date: 11 May 2011

ICHD-Environmental Health Division