IREDELL COUNTY HEALTH DEPARTMENT

STATESVILLE 704-878-5305 CJ MOORESVILLE 704-664-5281

IMPROVEMENT PERMIT / AUTHORIZATION TO CONSTRUCT / OPERATION PERMIT / EXISTING SYSTEM INSPECTION

PERMIT# 120026 PIN# 4629-63-~~5580~~ 5195 DATE 12-10-04

OWNER OR CONTRACTOR NEW HORIZON BUILDERS (MIKE HELMS) PHONE: Business 704-634-2900 Home 704-528-3219

ADDRESS 176 FERN HILL RD TROUTMAN, NC 28166

LOCATION STATE PARK ROAD (L) MORRISON FARM (R) APRIL (L) TAYPORT 2ND ON RT

SUBDIVISION CLJT BLOCK / SECTION 6 LOT 837B LOT AREA 1.08AC SITE CLASS. PS DESIGN FLOW 360 L.T.A.R. .3

Septic Tank: 1000 Gallons; STB 312 Date 12-31-04
Pump Tank: 1000 Gallons; PT 283 Date 2-9-05
Pump Make: [illegible] Model 9E-H Serial No. ——
Nitrification Field: No Fields 1 Square Feet EQ=1200' Linear Feet 300'
No Lines 3x100' Trench Width 36" Max Trench Bottom Depth 36" Gravel Depth N/A

☒ New System ☐ Repair System Type: I, II, ⓘ IV, V, VI
System Description: PUMP 25% REDUCT
Repair System Description: LP 50% REDUCT
Maintenance Agreement Required: ☐ Yes ☒ No

☒ House/Mod. Home No. Bedrooms 3
☐ Mobile Home No. Bathrooms 3
☐ Business No. Employees ____
☐ Other ____


Water Supply: ☒ Individual ☐ Public ☐ Community

☐ Slab ☐ Crawl Space ☒ Basement w/plumbing ☐ Basement wo/plumbing


Comments:/Conditions: (1) KEEP HOUSE OUT OF GROUND & BACKFILL FOR POSITIVE DRAINAGE REQMTS (2) 25' BASEMENT DRAIN SETBACKS OVERRIDES 15' POS DRNGE SETBACK (3) INSTALL LINES ON CONTOURS MAINTAIN SETBACKS. COMMENTS

Comments:/Conditions: (4) KEEP WELL 100' FROM SAPROLITE SEPTIC SYSTEM, (5) THIS PERMIT IS A LIMITED REDRAW. PREVIOUS PERMIT ISSUED ON 5-17-04 BY M. POTS[illegible], RS, (6) NEIGHBORING LOTS PERMIT IS EXPIRED. SEE ATTACHED

1" = 60' INITIAL SITE SKETCH

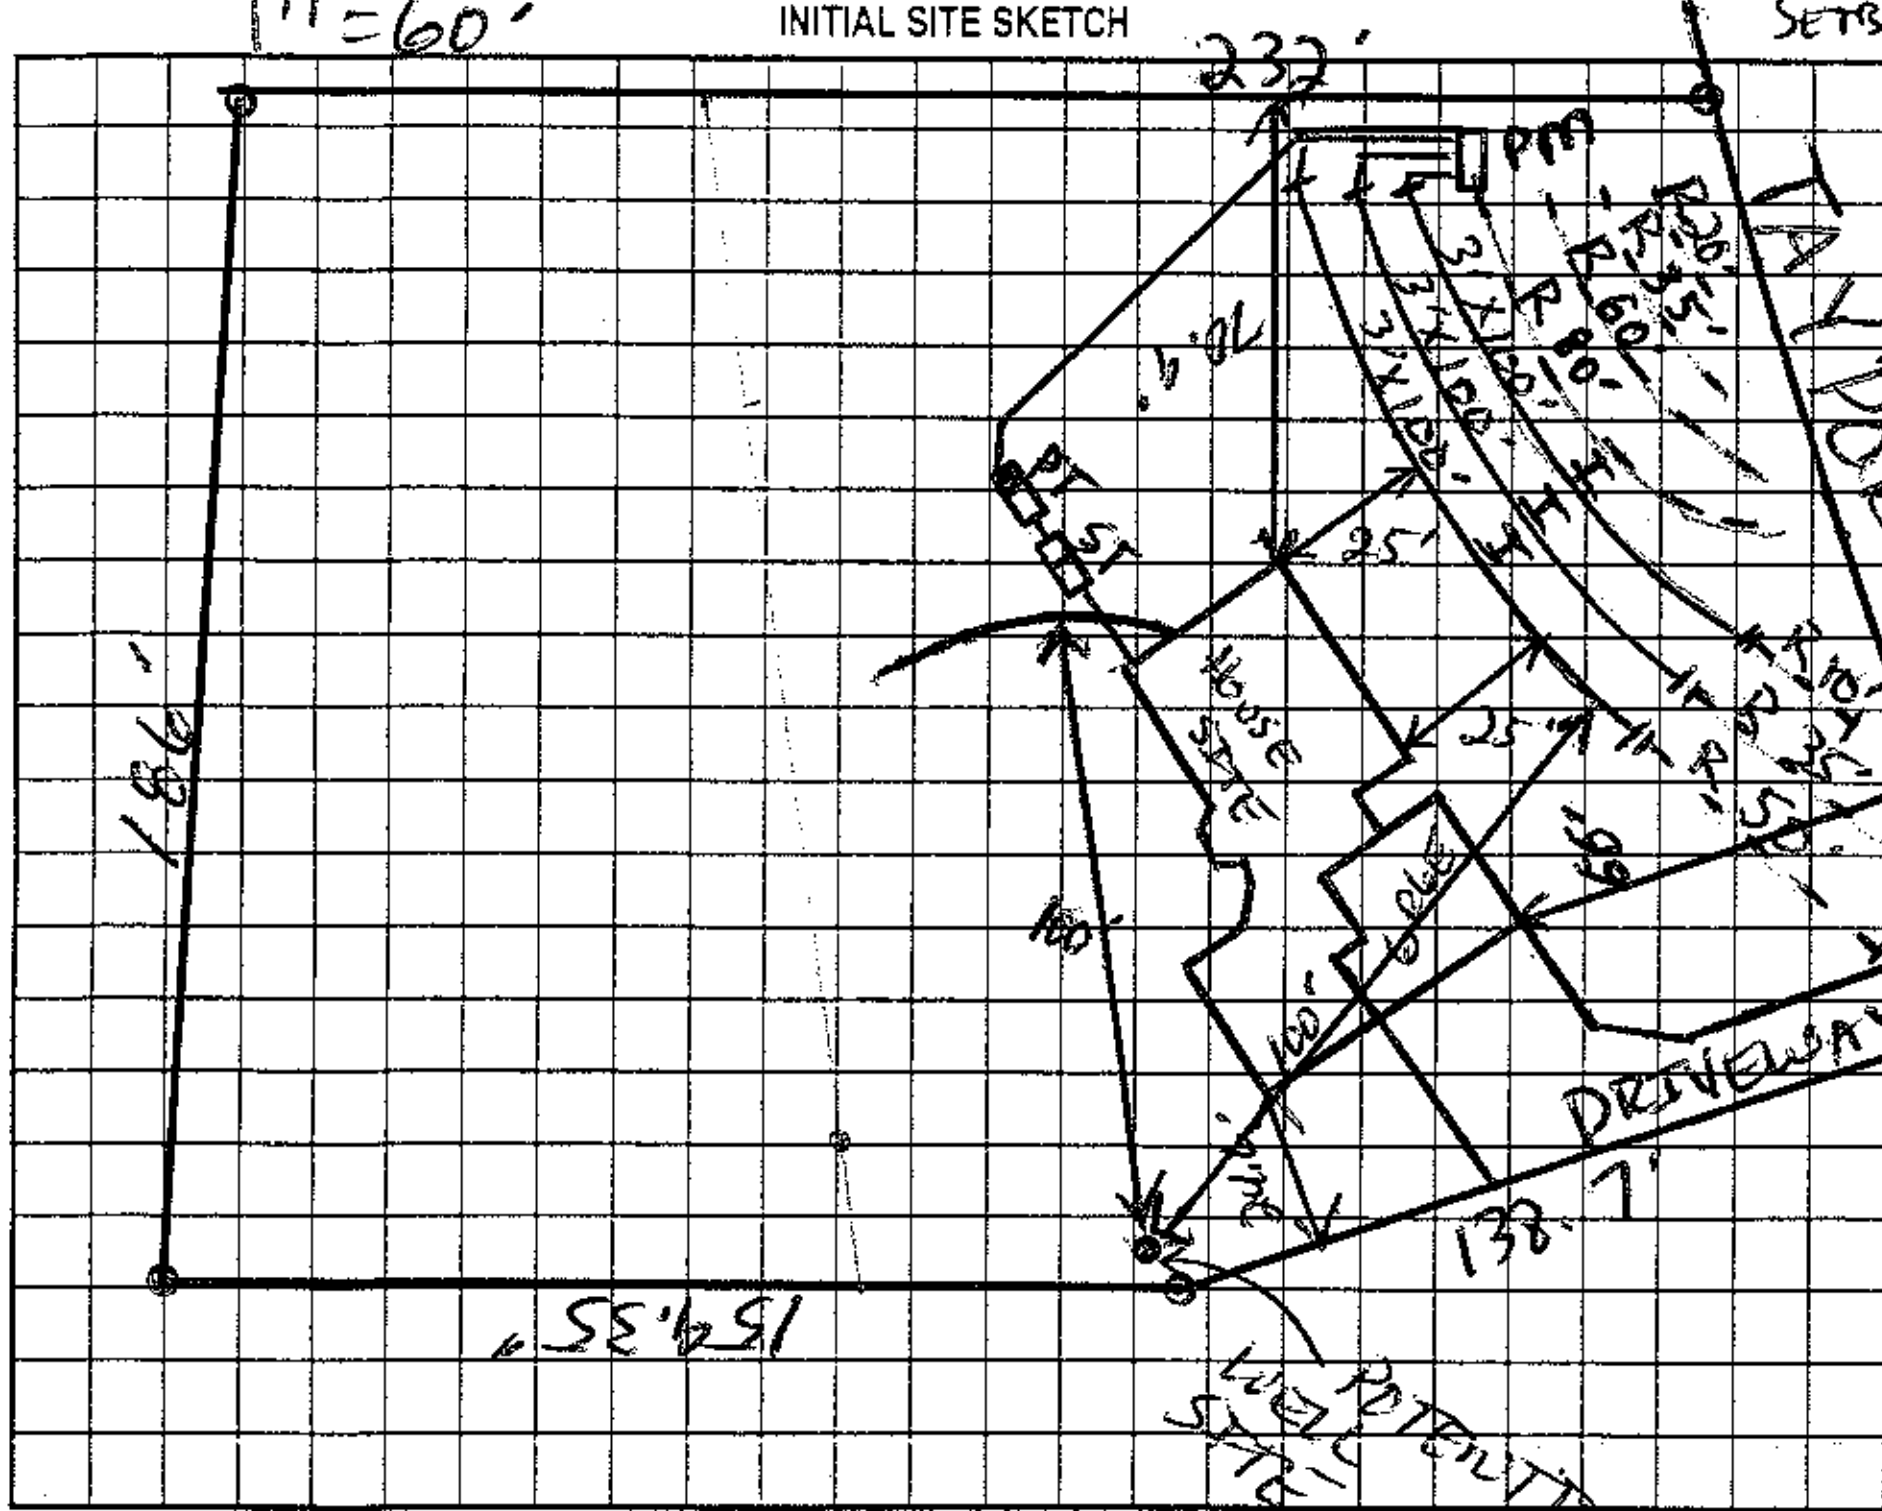

AS BUILT SKETCH

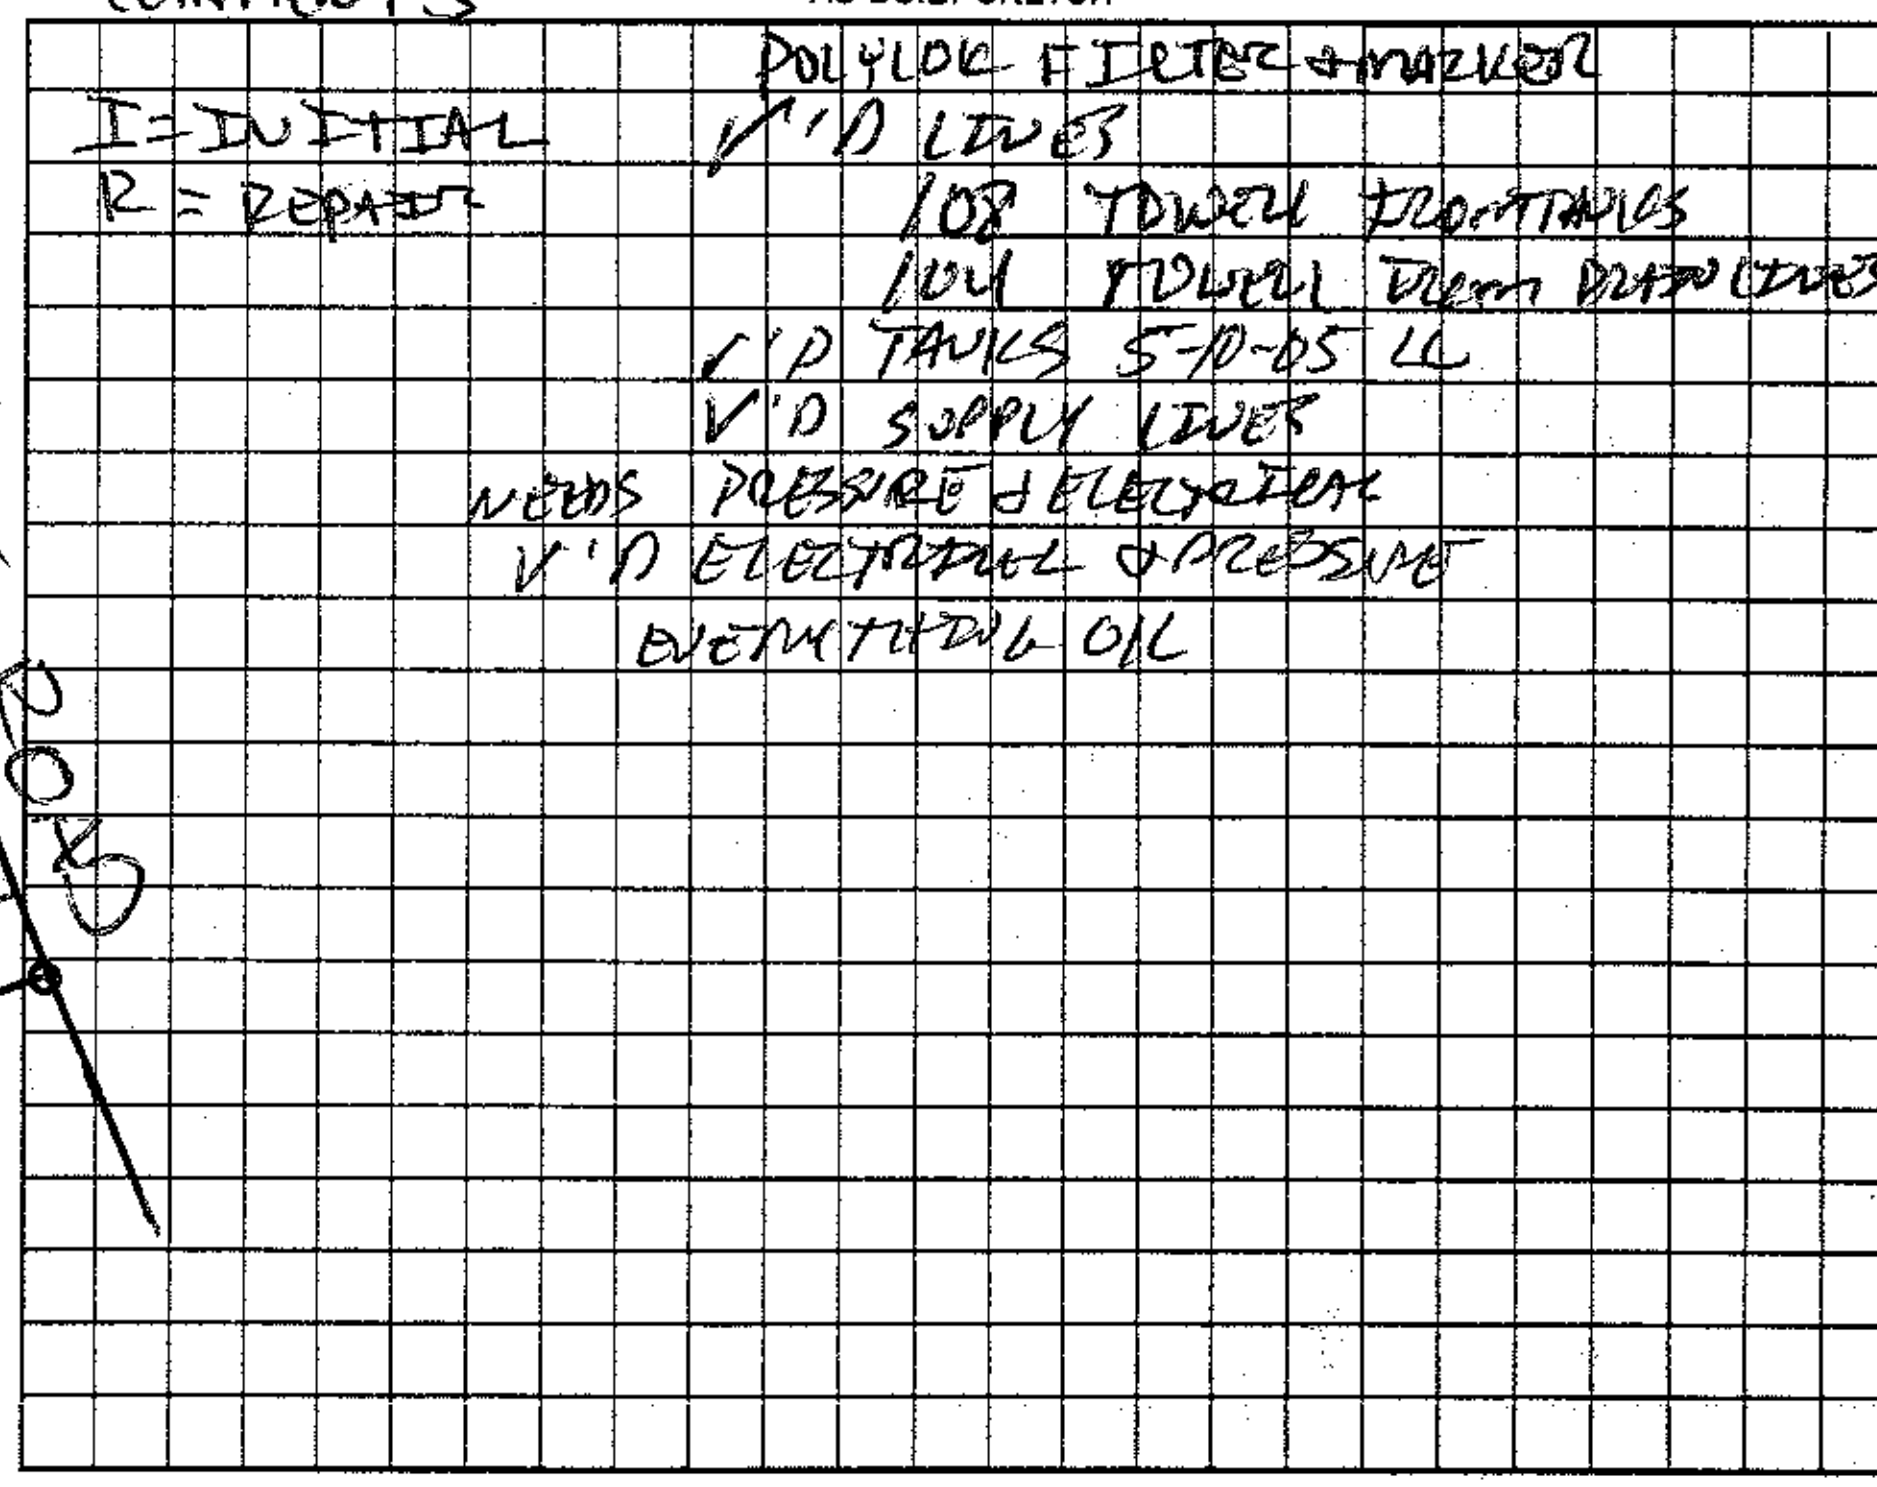

Permit can be suspended or revoked if any false information is supplied toward securing the permit/any unauthorized changes are made to the site/any unauthorized changes are made in the installation of the system. Improvement Permit with plat valid without expiration. Improvement Permit with site plan valid for sixty months. Authorization to Construct is valid for a period equal to that of Improvement Permit – not to exceed sixty months.

Signed: [signature] date 03-17-05 Installed by: ABERNATHY

Improvement Permit by: [signature] RS date 12-13-04 Operation Permit by: [signature] date 7/27/2005

Authorization to Construct by: [signature] RS date 12-13-04 Existing System Inspection by: ______ date ______

HEALTH DEPT. COPY: WHITE OWNER COPY (FINAL): YELLOW OWNER COPY (INITIAL): PINK