IREDELL COUNTY HEALTH DEPARTMENT

Statesville Office (704) 878-5305 Mooresville Office (704) 660-3625 PERMIT # 221756

RA

IMPROVEMENT PERMIT / AUTHORIZATION TO CONSTRUCT / OPERATION PERMIT / EXISTING SYSTEM

PIN # 4629635440

APPLICANT: Relia-Built Construction APPLICANT ADDRESS: 3797 Hwy 16N Denver, NC 28037

SITE ADDRESS: 118 Tayport Dr Troutman, NC 28166 PHONE: 704 966-1176 ALT. PHONE:

SITE DIRECTIONS: State Park Rd TL Morrison Farm TR April TL Tayport 2nd on Right

SUBDIVISION: CLAT LOT: 17 SECTION: 6 LOT # 83772 LOT AREA: 1.080 Ac DESIGN FLOW: Bedroom L.T.A.R.: .3

Septic Tank	Ex 1000 (gal)	STB		Date		☐ New System ☐ Repair ☐ Expansion System Type: I II (III) IV V VI		☒ Residence	No. Bedrooms	3	Water Supply
Pump Tank	Ex 1000 (gal)	PT		Date		System Description: Pump - 25% Reduction		☐ Business	No. Persons	6	☒ Private
Pump Make		Model		Serial #		Repair System Description: LP PPBPS		☐ Other	No. Employees		☐ Public
# Nitrification Fields	1	# Lines	3	Linear Ft:	300'	Maintenance Agreement Required: ☐ YES ☒ NO		☐ Slab	☐ Crawl Space		☐ Community
Trench Width	36"	Max. Trench Bottom Depth	36"	Gravel Depth	N/A	☐ GRAVITY ☒ PRESSURE		☒ Basement w/plumbing		☐ Basement w/o plumbing	


EXIST

Comments / Conditions:

Must keep deck at least 5ft from Septic System.
Replacing existing deck

The proposed deck replacement does not appear to impact the existing Septic System.

INITIAL SITE SKETCH

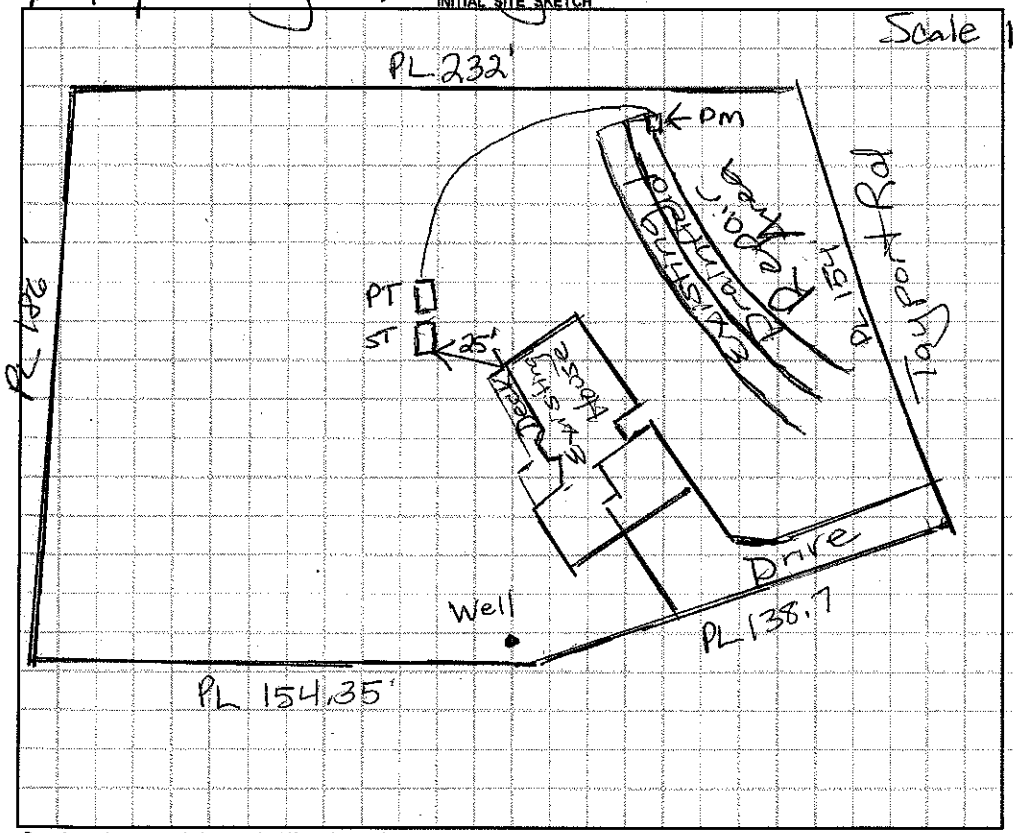

AS BUILT SKETCH

Permit can be suspended or revoked if any false information is supplied toward securing the permit / any unauthorized changes are made to the site / any unauthorized changes are made in the installation of the system. **CONTACT A LOCATOR SERVICE PRIOR TO ANY EXCAVATION**

☐ **IMPROVEMENT PERMIT** *with plat valid without expiration.* ☐ **IMPROVEMENT PERMIT** *with site plan valid for 60 mos.* ☐ **AUTHORIZATION TO CONSTRUCT** *valid for period equal to IMPROVEMENT PERMIT--not to exceed 60 mo.*

Owner / Applicant Signature: Heather Braddlow Date: 11/2/16 Installed by:

IMPROVEMENT PERMIT by: Date: OPERATION PERMIT by: Date:

AUTHORIZATION TO CONSTRUCT by: Date: Existing System Inspected by: Maria Dotson RS Date: 10/31/16

Health Dept. Copy - WHITE Applicant (Final Approval) - YELLOW Applicant (Conditional Approval) - PINK