Replaces Drawing issued 8-15-01 CT

...DELL COUNTY HEALTH DEPARTMENT

STATESVILLE 704-878-5305 MOORESVILLE 704-664-5281

IMPROVEMENT PERMIT / AUTHORIZATION TO CONSTRUCT / OPERATION PERMIT / EXISTING SYSTEM INSPECTION

PERMIT# 94446 Redraw PIN# 4629636925 DATE 1-10-06

OWNER OR CONTRACTOR Provident Development Group PHONE: Business Home

ADDRESS April Rd.

LOCATION Perth (R) on State Park (L) on Morrison Farm (R) on April - on (R)

SUBDIVISION Sunset Bay BLOCK / SECTION LOT 1 LOT AREA 31067 SQ FT SITE CLASS PS DESIGN FLOW 480 L.T.A.R. 3

Septic Tank: 1000 Gallons; STB 312 Date 10-5-5

Pump Tank: 1000 Gallons; PT 283 Date 10-5-5

Pump Make: Zoeller Model BN 153 Serial No.

Nitrification Field: No Fields 1 Square Feet 1200 Linear Feet 400

No Lines 4@ 100' Trench Width 36" Max Trench Bottom Depth 36" Gravel Depth

☒ New System ☐ Repair System Type: I, II, (III), IV, V, VI

System Description: Pump 25% Reduction

Repair System Description: LP Panel 50% Red

Maintenance Agreement Required: ☐ Yes ☒ No

☒ House/Mod. Home ☐ Mobile Home ☐ Business ☐ Other

No. Bedrooms 4 No. Bathrooms 4 No. Employees


☐ Slab ☑ Crawl Space ☐ Basement w/plumbing ☐ Basement wo/plumbing

Water Supply: ☐ Individual ☐ Public ☑ Community


Comments:/Conditions:

Comments:/Conditions:

INITIAL SITE SKETCH

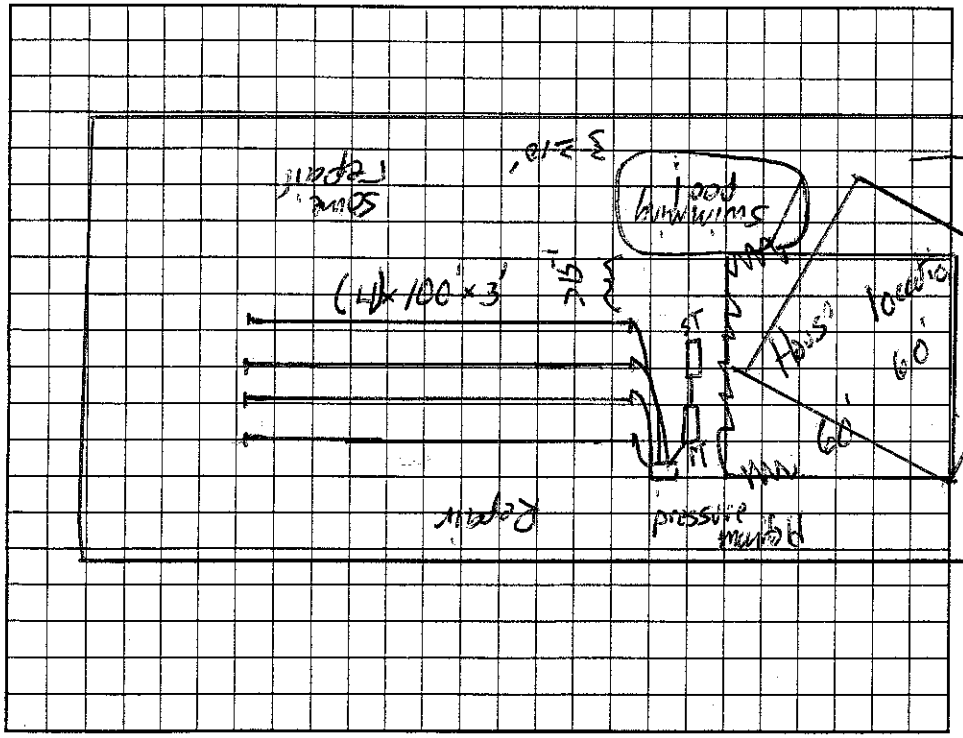

AS BUILT SKETCH

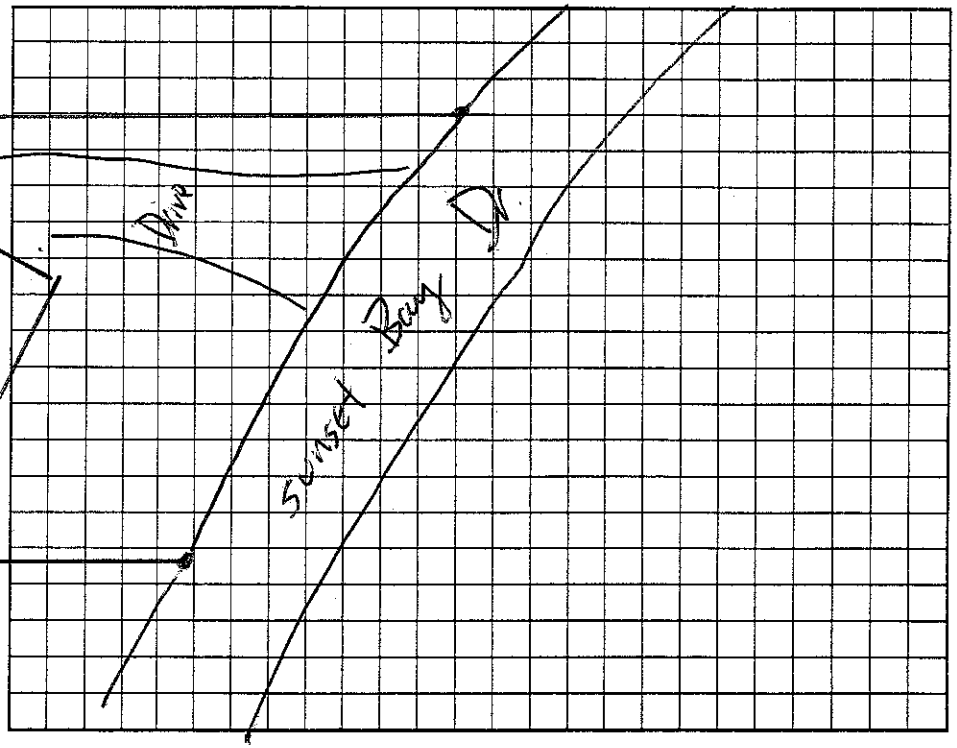

Permit can be suspended or revoked if any false information is supplied toward securing the permit/any unauthorized changes are made to the site/any unauthorized changes are made in the installation of the system. Improvement Permit with plat valid without expiration. Improvement Permit with site plan valid for sixty months. Authorization to Construct is valid for a period equal to that of Improvement Permit – not to exceed sixty months.

Signed: Synergy Earth LLC date 2-21-06 Installed by: Provident Const.

Improvement Permit by: [signature] - Redraw date 2-21-06 Operation Permit by: [signature] date 3-30-06

Authorization to Construct by: [signature] - Redraw date 2-21-06 Existing System Inspection by: date

HEALTH DEPT. COPY: WHITE OWNER COPY (FINAL): YELLOW OWNER COPY (INITIAL): PINK