1.00

IREDELL COUNTY HEALTH DEPARTMENT

STATESVILLE 704-878-5305 MOORESVILLE 704-664-5281

IMPROVEMENT PERMIT / AUTHORIZATION TO CONSTRUCT / OPERATION PERMIT / EXISTING SYSTEM INSPECTION

PERMIT# 138740 PIN# 4629641079 DATE 11-8-06

OWNER OR APPLICANT MILLER - McCormick INVESTMENTS PHONE: Business 704-692-6340 Home

ADDRESS PERTH RD (A) Morrison Farm (B) SUNSET BAY (C) COVEDALE ATTND TO LEFT #872 B HARBOR CIRCLE TROUTMAN, NC 28166

LOCATION PERTH RD (A) SHARPESBURG RD (B) SUNSET BAY (C) COVEDALE ATTND TO LEFT

SUBDIVISION SUNSET BAY BLOCK / SECTION LOT 9 LOT AREA .582 + OFFSITE SITE CLASS PS DESIGN FLOW 480 L.T.A.R. .3

Septic Tank: 1000 Gallons: STB 1017 Date 10-25-06

Pump Tank: 1000 Gallons: PT 17 Date 1-30-07

Pump Make: Goulds Model WE0J2H Serial No.

Nitrification Field: No Fields 1 Square Feet ED=1600' Linear Feet 270'

No Lines 6x45' Trench Width 24" Max Trench Bottom Depth 36"

☒ New System ☐ Repair ☐ Expansion System Type: I II (III) IV V VI

System Description: Pump 50% Reduction

Repair System Description: LP 50% Reduction

Maintenance Agreement Required: ☐ Yes ☒ No

Gravel Depth N/A ☐ Gravity ☒ Pressure

☒ House/Mod. Home ☐ Mobile Home ☐ Business ☐ Other

No. Bedrooms 4 No. Persons 8 No. Employees


Water Supply: ☐ Individual ☐ Public ☒ Community

☐ Slab ☒ Crawl Space ☐ Basement w/plumbing ☐ Basement wo/plumbing

Comments/Conditions: (D) FILL & PACK WKHOUT (E) INSTALL LINES ON CONTOURS *MAINTAIN SETBACKS (3) House & Drain Lines FLAGGED OUT

INITIAL SITE SKETCH

1" = 100'

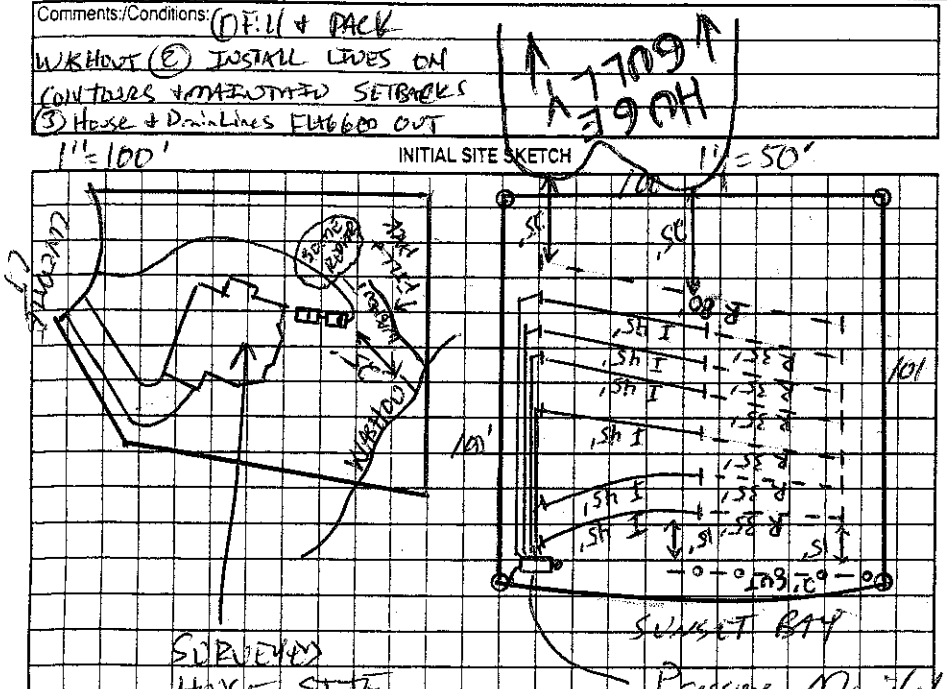

1" = 50'

Comments/Conditions: (4) SOME REPAIR LISTED ON THE HOUSE PLACEMENT LOT DUE TO IF GOULD WASHES OUT MORE, NOW LAST REPAIR LINE IS 25' UPSLOPE FROM GOULD YOU NEIGHBORS LOT. (5) START SEPTIC LINES 10' OFF P/L & SUPPLY LINES 5' OFF P/L TO MAXIMIZE THE REPAIR AREA

AS BUILT SKETCH

I = Initial
R = Repair


Permit can be suspended or revoked if any false information is supplied toward securing the permit/any unauthorized changes are made to the site/any unauthorized changes are made in the installation of the system. Improvement Permit with plat valid without expiration ☐ Improvement Permit with site plan valid for sixty months ☒ Authorization to Construct is valid for a period equal to that of Improvement Permit – not to exceed sixty months.

Signed: _____ date 11-13-06 Installed by: Tommy Ingle

Improvement Permit by: _____ date 11-8-06 Operation Permit by: _____ date 8-2-07

Authorization to Construct by: _____ date 11-8-06 Existing System Inspection by: _____ date _____

HEALTH DEPT. COPY: WHITE OWNER COPY (FINAL): YELLOW OWNER COPY (INITIAL): PINK