# IREDELL COUNTY HEALTH DEPARTMENT

* This permit voids Previously issued permit dated 12/6/02.

STATESVILLE 704-878-5305 CI MOORESVILLE 704-664-5281

## IMPROVEMENT PERMIT / AUTHORIZATION TO CONSTRUCT / OPERATION PERMIT / EXISTING SYSTEM INSPECTION

PERMIT# 99560 PIN# 4629-64-[redacted] 1843 DATE 9/9/03

OWNER OR CONTRACTOR Provident Homes PHONE: Business (704) 201-5522 Home —

ADDRESS 6707 Fairview Road Charlotte N.C. 28210

LOCATION Perth Rd, (R) State Park Rd (L) Morrison Farm Rd (R) Sunset Bay @ End of cul-de-sac on Right

SUBDIVISION Sunset Bay BLOCK / SECTION — LOT 15 LOT AREA 0.9 Acres SITE CLASS: PS DESIGN FLOW 360 L.T.A.R. 0.30 Acre

Septic Tank: 4000 Gallons; STB# PT 283 Date 6-7-29-03

Pump Tank: 4000 Gallons; PT# STB 312 Date 5-26-03

Pump Make: Myers Model ME 50S-21 Equiv Serial No. —

Nitrification Field: No Fields 1 Square Feet 1,200 Linear Feet 300

No Lines 3@100 Trench Width 36" Max Trench Bottom Depth 36" Gravel Depth NA

[X] New System [ ] Repair System Type: I, II, (III), IV, V, VI

System Description: Pump 25% Reduction

Repair System Description: 50% Reduction Low Pressure

Maintenance Agreement Required: [ ] Yes [X] No

[X] House/Mod. Home [ ] Mobile Home [ ] Business [ ] Other

No. Bedrooms 3 No. Bathrooms 3 No. Employees —

[ ] Slab [ ] Crawl Space [X] Basement w/plumbing [ ] Basement wo/plumbing

Water Supply: [ ] Individual [ ] Public [X] Community

Comments:/Conditions:

Comments:/Conditions:


ST + PT Risers Installed

Tuff Tite Filter Installed


Pressure check Electricity Alarm okay

Scale 1" = 50'

INITIAL SITE SKETCH

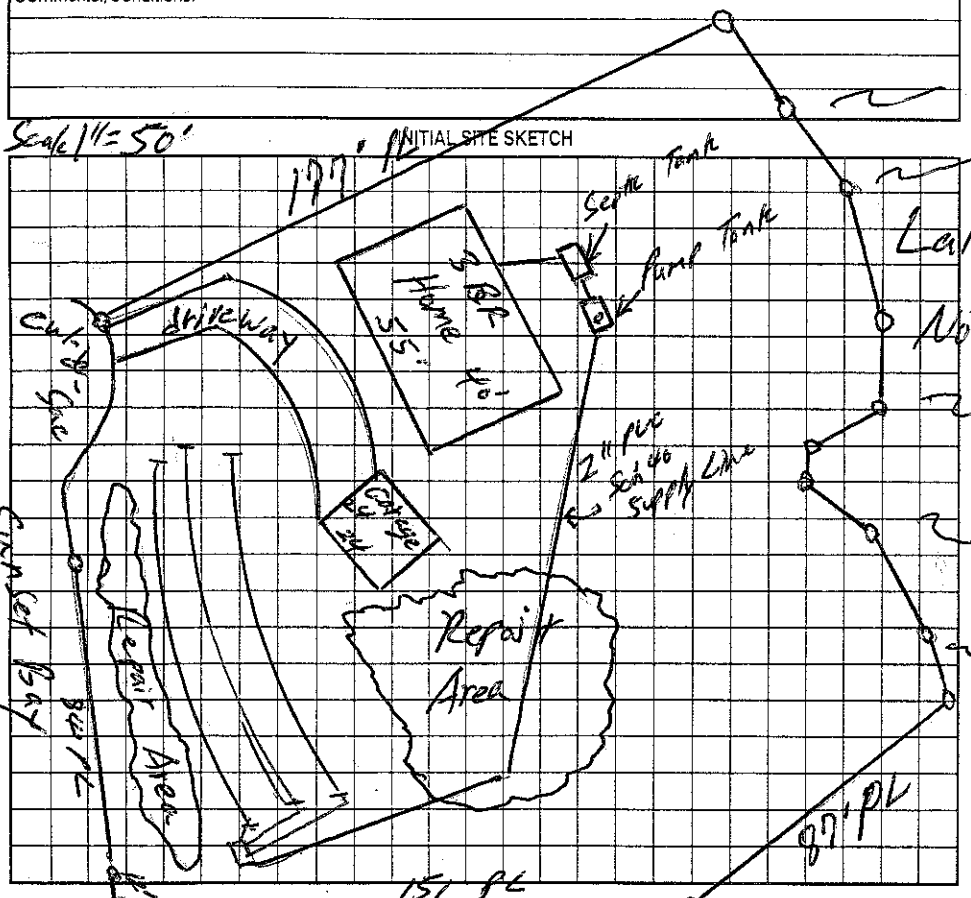


AS BUILT SKETCH

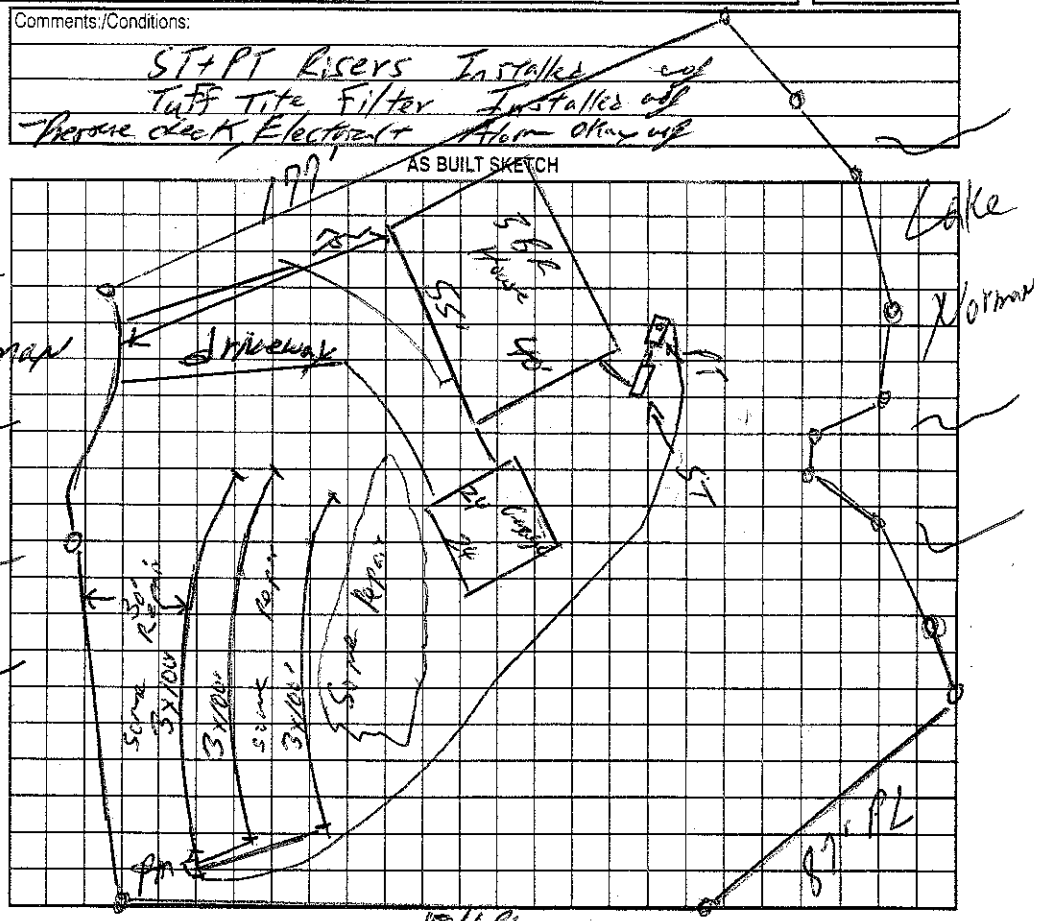


Permit can be suspended or revoked if any false information is supplied toward securing the permit/any unauthorized changes are made to the site/any unauthorized changes are made in the installation of the system. Improvement Permit with plat valid without expiration. Improvement Permit with site plan valid for sixty months. Authorization to Construct is valid for a period equal to that of Improvement Permit – not to exceed sixty months.

Signed: [signature] FOR PROVIDENT HOMES date 9-9-03

Improvement Permit by: William O. Johnson date 9/4/03

Authorization to Construct by: William O. Johnson date 9/4/03

Installed by: Brad Russell / R+H of Lake Norman Inc.

Operation Permit by: William O. Johnson date 9/10/03

Existing System Inspection by: _____ date _____

HEALTH DEPT. COPY: WHITE OWNER COPY (FINAL): YELLOW OWNER COPY (INITIAL): PINK