WARREN SMITH

# IREDELL COUNTY HEALTH DEPARTMENT

THIS PERMIT VOIDS PREVIOUS ISSUED 10-26-01

STATESVILLE 704-878-5305 MOORESVILLE 704-664-5281

## IMPROVEMENT PERMIT / AUTHORIZATION TO CONSTRUCT / OPERATION PERMIT / EXISTING SYSTEM INSPECTION

PERMIT# 094556 115209 PIN# 4629 64 1771 4629-954-9656 / 4629-64-8747 DATE 8-11-03

OWNER OR CONTRACTOR COURTLAND PROPERTIES PHONE: Business 704-363-1622 Home

ADDRESS 8468 QUEENS CT, CATAWBA, NC 28609

LOCATION US 21S, TR PERTH, TR STATE PARK, TL MORRISON FARM RD, TR SUNSET BAY DRIVE, LOT AT END ON LEFT

SUBDIVISION SUNSET BAY BLOCK / SECTION LOT 12 LOT AREA 0.78 ACRES SITE CLASS. PS DESIGN FLOW 480 L.T.A.R. 0.30 GPD/FT²

Septic Tank: 1000 Gallons: STB 1012 Date 2-3-04

Pump Tank: 1000 Gallons: PI 27 Date 2-17-04

Pump Make: DELLINGER 20 YEARS Model ME-100 Serial No.

Nitrification Field: No Fields 1 Square Feet 60 TO 1600 Linear Feet 270

No Lines THREE Trench Width 24" Max Trench Bottom Depth 36" Gravel Depth 24" SAND

☑ New System ☐ Repair System Type: I, II, III, IV, V, VI

System Description: 50% REDUCTION, LOW-PRESSURE

Repair System Description: 50% REDUCTION, LOW-PRESS

Maintenance Agreement Required: ☑ Yes ☐ No

☑ House/Mod. Home ☐ Mobile Home ☐ Business ☐ Other

No. Bedrooms 4 No. Bathrooms 4 No. Employees

Water Supply: ☐ Individual ☐ Public ☑ Community


☐ Slab ☐ Crawl Space ☑ Basement w/plumbing ☐ Basement wo/plumbing

Comments:/Conditions: INSTALL 50% REDUCTION SYSTEM IN THREE LINES ON CONTOUR AS FLAGGED USING 62 PABCO PANELS, SEE ATTACHED SHEETS FOR PUMP & PRESSURE DISTRIBUTION. A CONTRACT SHALL BE EXECUTED WITH A MANAGEMENT ENTITY PRIOR TO ISSUANCE OF OPERATION PERMIT.


Comments:/Conditions: ① ZABEL FILTER + MARKER 12/19/97

SUPPLY LINE NOT V'D BY HEALTH DEPT. INSTALLED PRIOR TO INSTALLATIONS OF ROADS.

INITIAL SITE SKETCH

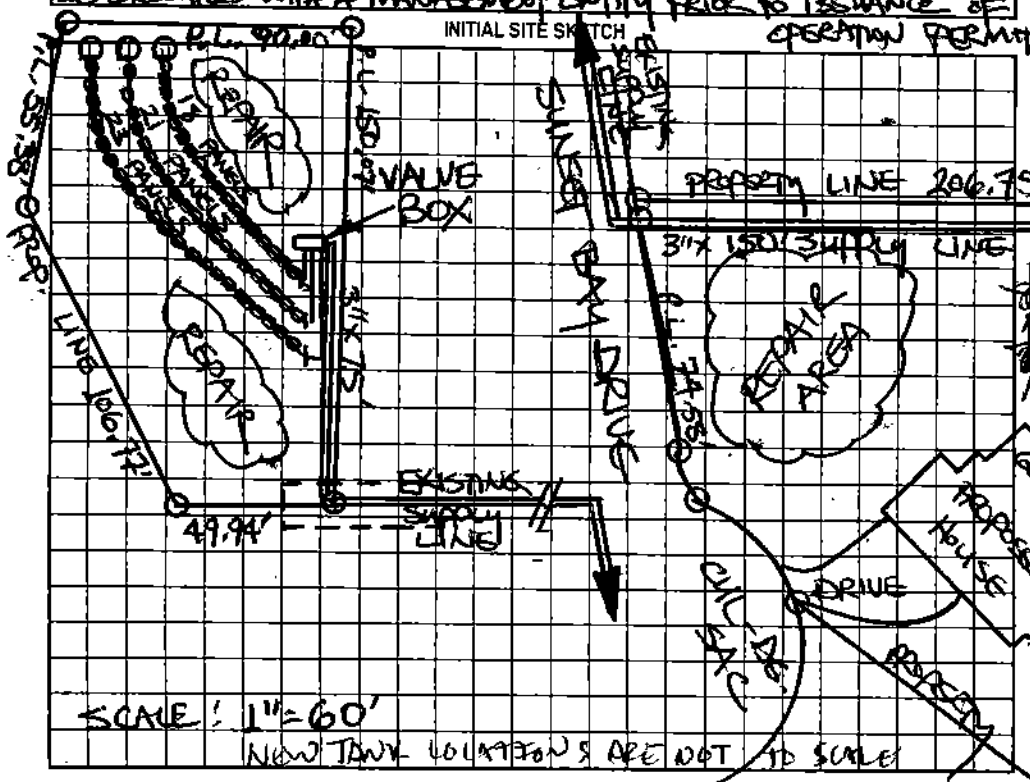


AS BUILT SKETCH

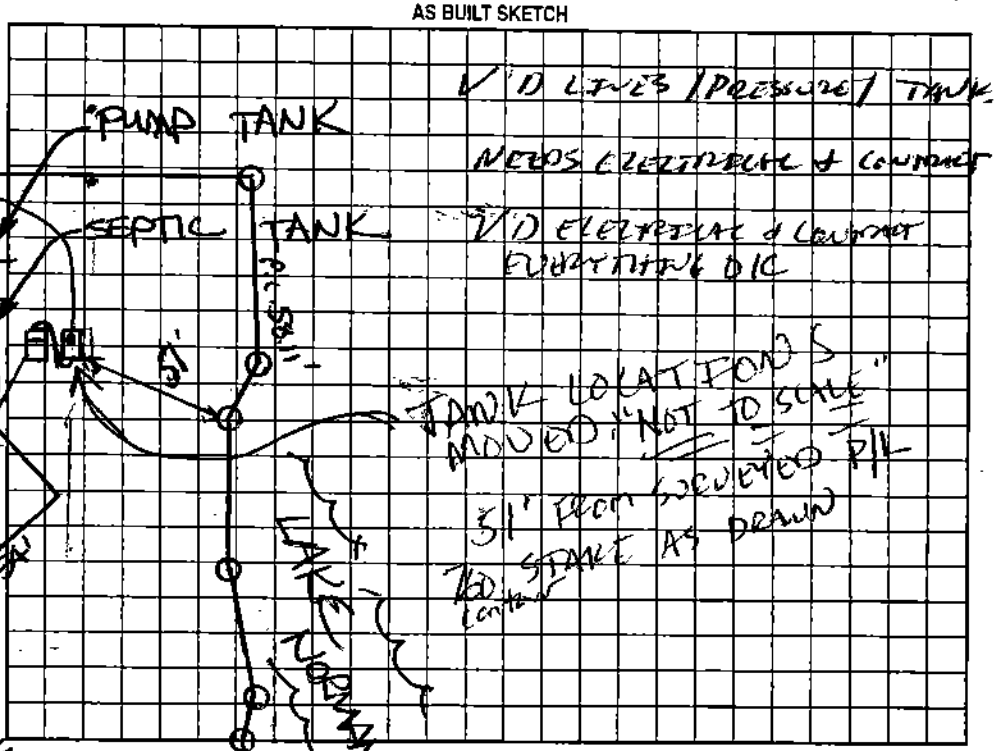


Permit can be suspended or revoked if any false information is supplied toward securing the permit/any unauthorized changes are made to the site/any unauthorized changes are made in the installation of the system. Improvement Permit with plat valid without expiration. Improvement Permit with site plan valid for sixty months. Authorization to Construct is valid for a period equal to that of Improvement Permit – not to exceed sixty months.

Signed: _____ date 8-12-03 Installed by: STANLEY SEPTIC SERVICE

Improvement Permit by: STEVE HEDRICK date 8-11-03 Operation Permit by: _____ date 4-13-04

Authorization to Construct by: STEVE HEDRICK date 8-12-03 Existing System Inspection by: _____ date _____

HEALTH DEPT. COPY: WHITE OWNER COPY (FINAL): YELLOW OWNER COPY (INITIAL): PINK