Pd Type III Fee $150.00

2:00

IREDELL COUNTY HEALTH DEPARTMENT

STATESVILLE 704-878-5305 MOORESVILLE 704-664-5281

IMPROVEMENT PERMIT / CERTIFICATE OF COMPLETION / OPERATION PERMIT / EXISTING SYSTEM INSPECTION

PROPERTY DESCRIPTION NO. 24129 DATE 7-9-96 TAX MAP NO. 3C-11-A-192 Watershed: ☐ Yes ☐ No

OWNER OR CONTRACTOR Anthony Pentry PHONE: Business Home 910 869 5538

ADDRESS 1153 Honey Town Rd High Point NC 27265

LOCATION St Rt #1 TL Morrison Fm TR Bunstine Rd at Forks

SUBDIVISION Lakeforman BLOCK / SECTION 17 LOT 192 LOT AREA 3/4 acre SITE CLASS. PS DESIGN FLOW 360 L.T.A.R. .3

Septic Tank: 1000 Gallons; STB 750 Date 6-9-96

Pump Tank: _____ Gallons; PT _____ Date _____

Pump Make: _____ Model _____ Serial No. _____

Nitrification Field: No Fields 1 Square Feet 900 Linear Feet 300

No Lines 3 Trench Width 36 Max Trench Bottom Depth 36 Gravel Depth N/A

☑ New System ☐ Repair System Type: I, II, ☑ IV, V, VI

System Description: Gravity Chambers

Repair System Description: Pump to ..

Maintenance Agreement Required: ☐ Yes ☐ No

☑ House/Mod. Home No. Bedrooms 3

☐ Mobile Home No. Bathrooms 2

☐ Business No. Employees ____

☐ Other ____


☐ Slab ☐ Crawl Space ☐ Basement w/plumbing ☑ Basement wo/plumbing

Water Supply: ☑ Individual ☐ Community ☐ Public


Comments:

Comments: House not on site at Time of This inspection

INITIAL SITE SKETCH

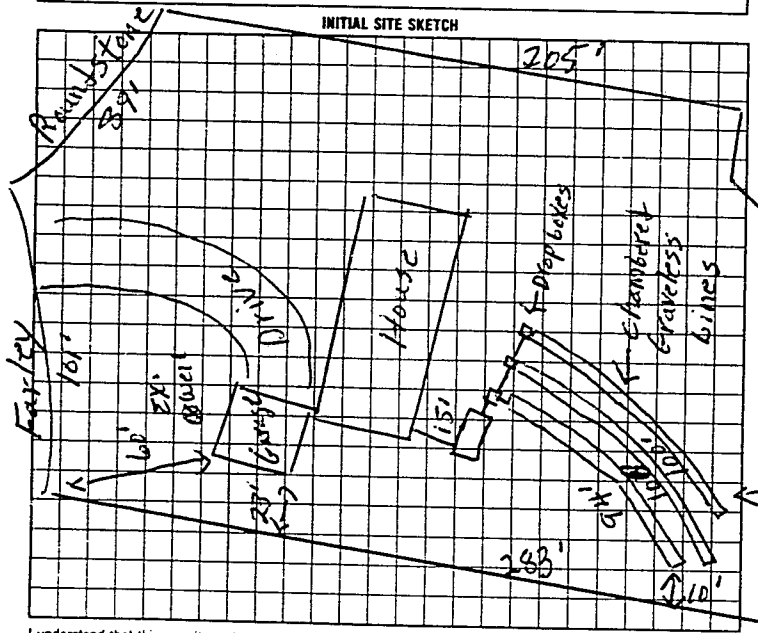

AS BUILT SKETCH

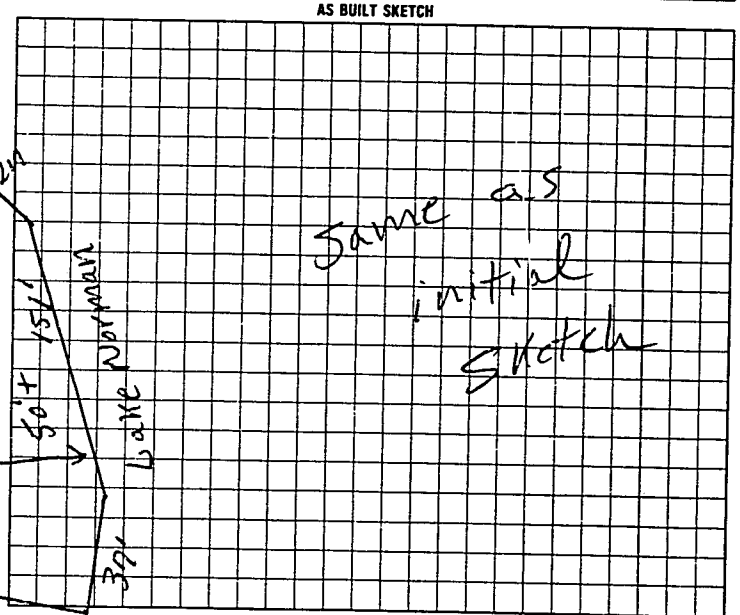

I understand that this permit can be suspended or revoked if any false information is supplied toward securing the permit/any unauthorized changes are made to the site/any unauthorized changes are made in the installation of the system.

Signed: _____

Improvement Permit by: R.C. Moore date 7-9-96

Existing System Inspection by: R.C. Moore date 7-9-96

Authorization to cover

Installed by: William Blake Trucking (Davie Co.)

Certificate of Completion by: _____ date _____

Operation Permit by: R.C. Moore date 8-16-96

HEALTH DEPT COPY WHITE INSPECTION COPY (FINAL) GREEN OWNER COPY (FINAL) YELLOW INSPECTION COPY (INITIAL) PINK OWNER COPY (INITIAL) GOLD

Authorization to cover EXPIRES 60 mos From issue

88 1 00