#134271 Jeffrey Sparks

IREDELL COUNTY HEALTH DEPARTMENT

IMPROVEMENT PERMIT / AUTHORIZATION TO CONSTRUCT / OPERATION PERMIT / EXISTING SYSTEM INSPECTION

STATESVILLE 704-878-5305 325.00 Paid MOORESVILLE 704-664-5281

PERMIT# ~~094585~~ PIN# 4629664117 T2 4629-65-5025

OWNER OR CONTRACTOR PROVIDENCE DEV PHONE: Business 367-0167 DATE 10/10/01

ADDRESS 6707 FAIRVIEW RD SUITE B CHARLOTTE NC 28210 Home

LOCATION STATE PARK - TL MORRISON FARM - TR ROUNDSTONE - ON LT AT END

SUBDIVISION LAUREWAY ESTATES BLOCK / SECTION LOT 7 LOT AREA SITE CLASS PS DESIGN FLOW 450 GPD L.T.A.R. .360/FT

Septic Tank: 1000 Gallons; STB 1000 Date 6-7-06

Pump Tank: 1000 Gallons; PT 314 Date 6-5-06

Pump Make: Model PE51M Serial No. PE51M

Nitrification Field: No Fields 1 Square Feet 540 Linear Feet 270

No Lines 3@90' Trench Width 24" Max Trench Bottom Depth 36" Gravel Depth N/A

☑ New System ☐ Repair System Type: I, II, III, IV, V, VI

System Description: LP PANEL

Repair System Description: LP PANEL

Maintenance Agreement Required: ☑ Yes ☐ No

☑ House/Mod. Home ☐ Mobile Home ☐ Business ☐ Other

No. Bedrooms 4 No. Bathrooms 4 No. Employees


Water: ☐ Individual ☐ Public ☑

☐ Slab ☐ Crawl Space ☑ Basement w/plumbing ☐ Basement wo/plumbing


Comments/Conditions: 1) KEEP TANKS 50' FROM 760' LAKE NORMAN CONTOUR 2) SEE REVISED PLAT FOR LOT CHANGE AND NUMBER CHANGE

Comments/Conditions: PT - TANK RISER
ST TANK RISER
ST White Septech Filter
PT Semi Teed Filter

INITIAL SITE SKETCH 1"=50'

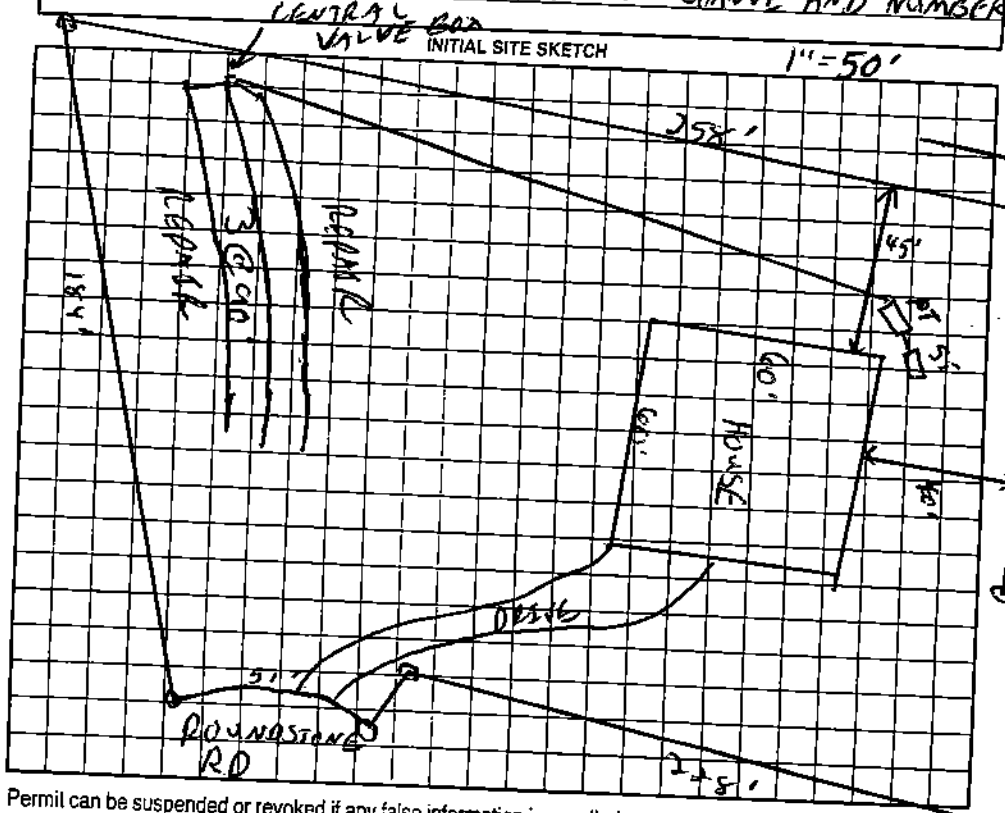

AS BUILT SKETCH

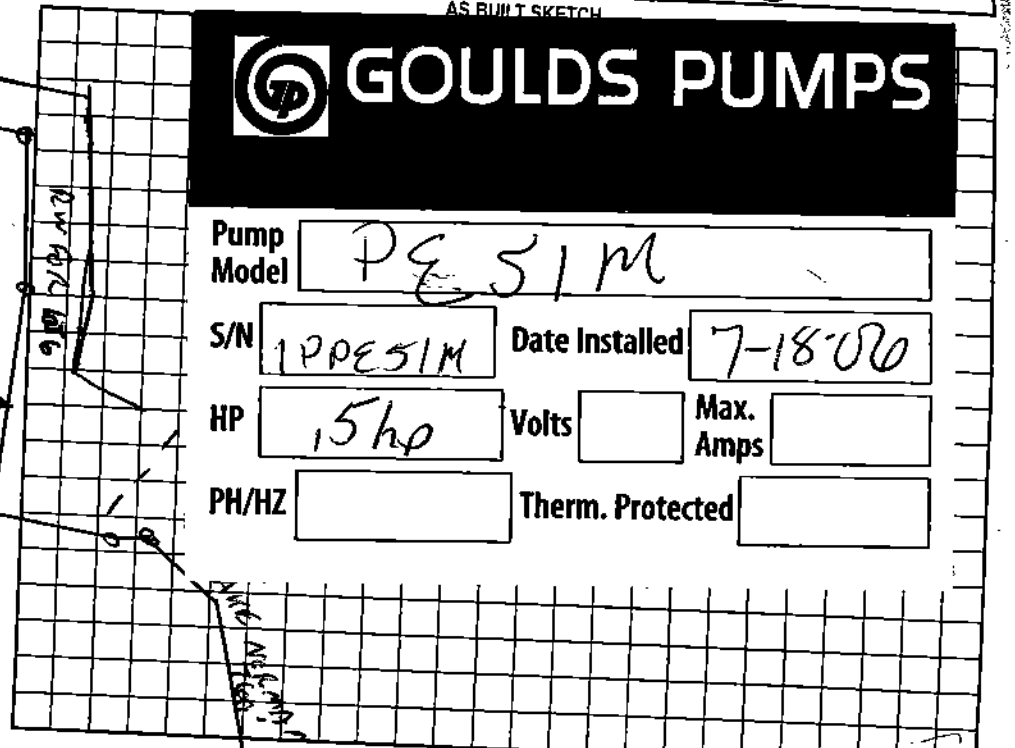

GOULDS PUMPS

Pump Model PE51M

S/N 1PPE51M Date Installed 7-18-06

HP .5hp Volts Max. Amps

PH/HZ Therm. Protected

Permit can be suspended or revoked if any false information is supplied toward securing the permit/any unauthorized changes are made to the site/any unauthorized changes are made in the installation of the system. Improvement Permit with plat valid without expiration. Improvement Permit with site plan valid for sixty months. Authorization to Construct is valid for a period equal to that of Improvement Permit – not to exceed sixty months.

Signed:

Improvement Permit by: date 10-11-01

Authorization to Construct by: date 10/10/01

Installed by: Richard Abernathy 4-26-2006

Operation Permit by: Kelli Cox 9-7