Replaces Perm A dated 24 August 10

IREDELL COUNTY HEALTH DEPARTMENT ENVIRONMENTAL HEALTH ☑ STATESVILLE OFFICE 704-878-5305 ☐ MOORESVILLE OFFICE 704-664-5281

IMPROVEMENT PERMIT / AUTHORIZATION TO CONSTRUCT / OPERATION PERMIT / EXISTING SYSTEM INSPECTION

PERMIT # 163098 PIN # 4629-65-6787 DATE 31 MARCH 2011

OWNER Bruce + Jane Rogers APPLICANT: PHONE: Home/~~Cell~~ # (704) 202-1266 Business #

SITE ADDRESS 152 Roundstone Rd. Troutman OWNER / APPLICANT ADDRESS

SITE DIRECTIONS State Park Rd. TL Morrison Farm TR Roundstone Lot on Rt

SUBDIVISION Cowans Ford BLOCK / SECTION LOT # 182 LOT AREA 0.64 Ac. DESIGN FLOW 360 gpd L.T.A.R. 0.35 gpd/ft²

Septic Tank 1000 Gallons: STB 312 Date ~~3-30-11~~ 5-2-11

Pump Tank 1000 Gallons: PT 27 Date 3-30-11

Pump Make Gould Model PE51 ½ hp Serial #

No. Nitrification Fields: 1 No. Lines 6 Linear Feet 185

Trench Width 24" Max. Trench Bottom Depth 36" Gravel Depth NA

☑ New System ☐ Repair ☐ Expansion System Type I II III IV V VI

System Description: PPBPS with LPP distribution

Repair System Description: ~~Not required~~ 1945 *

Maintenance Agreement Required ☑ YES ☐ NO

☐ GRAVITY ☑ PRESSURE

☑ Residence No. Bedrooms 3

☐ Business No. Persons

☐ Other No. Employees

☐ Slab ☐ Crawl Space

☑ Basement w/plumbing ☐ Basement w/o plumbing

Water Supply: ☐ Private ☐ Public ☑ Community

Comments / Conditions: All site work performed by Michael Athanas & Associates. Reviewed by Iredell Co.

* Maximum Footable Area required.

INITIAL SITE SKETCH

Install according to the attached site plan and specifications prepared by Michael Athanas and Associates.

AS BUILT SKETCH

Installed as Drawn on Site Plan

Permit can be suspended or revoked if any false information is supplied toward securing the permit / any unauthorized changes are made to the site / any unauthorized changes are made in the installation of the system.

☐ *IMPROVEMENT PERMIT with plat valid without expiration.* ☑ *IMPROVEMENT PERMIT with ~~plat~~ site plan valid 60 mo.* ☑ *AUTHORIZATION TO CONSTRUCT* valid for period equal to IMPROVEMENT PERMIT--not to exceed 60 mo.

Owner / Applicant Signature: Date

IMPROVEMENT PERMIT by: REHS Date 31 March 11

AUTHORIZATION TO CONSTRUCT by: REHS Date 31 March 11

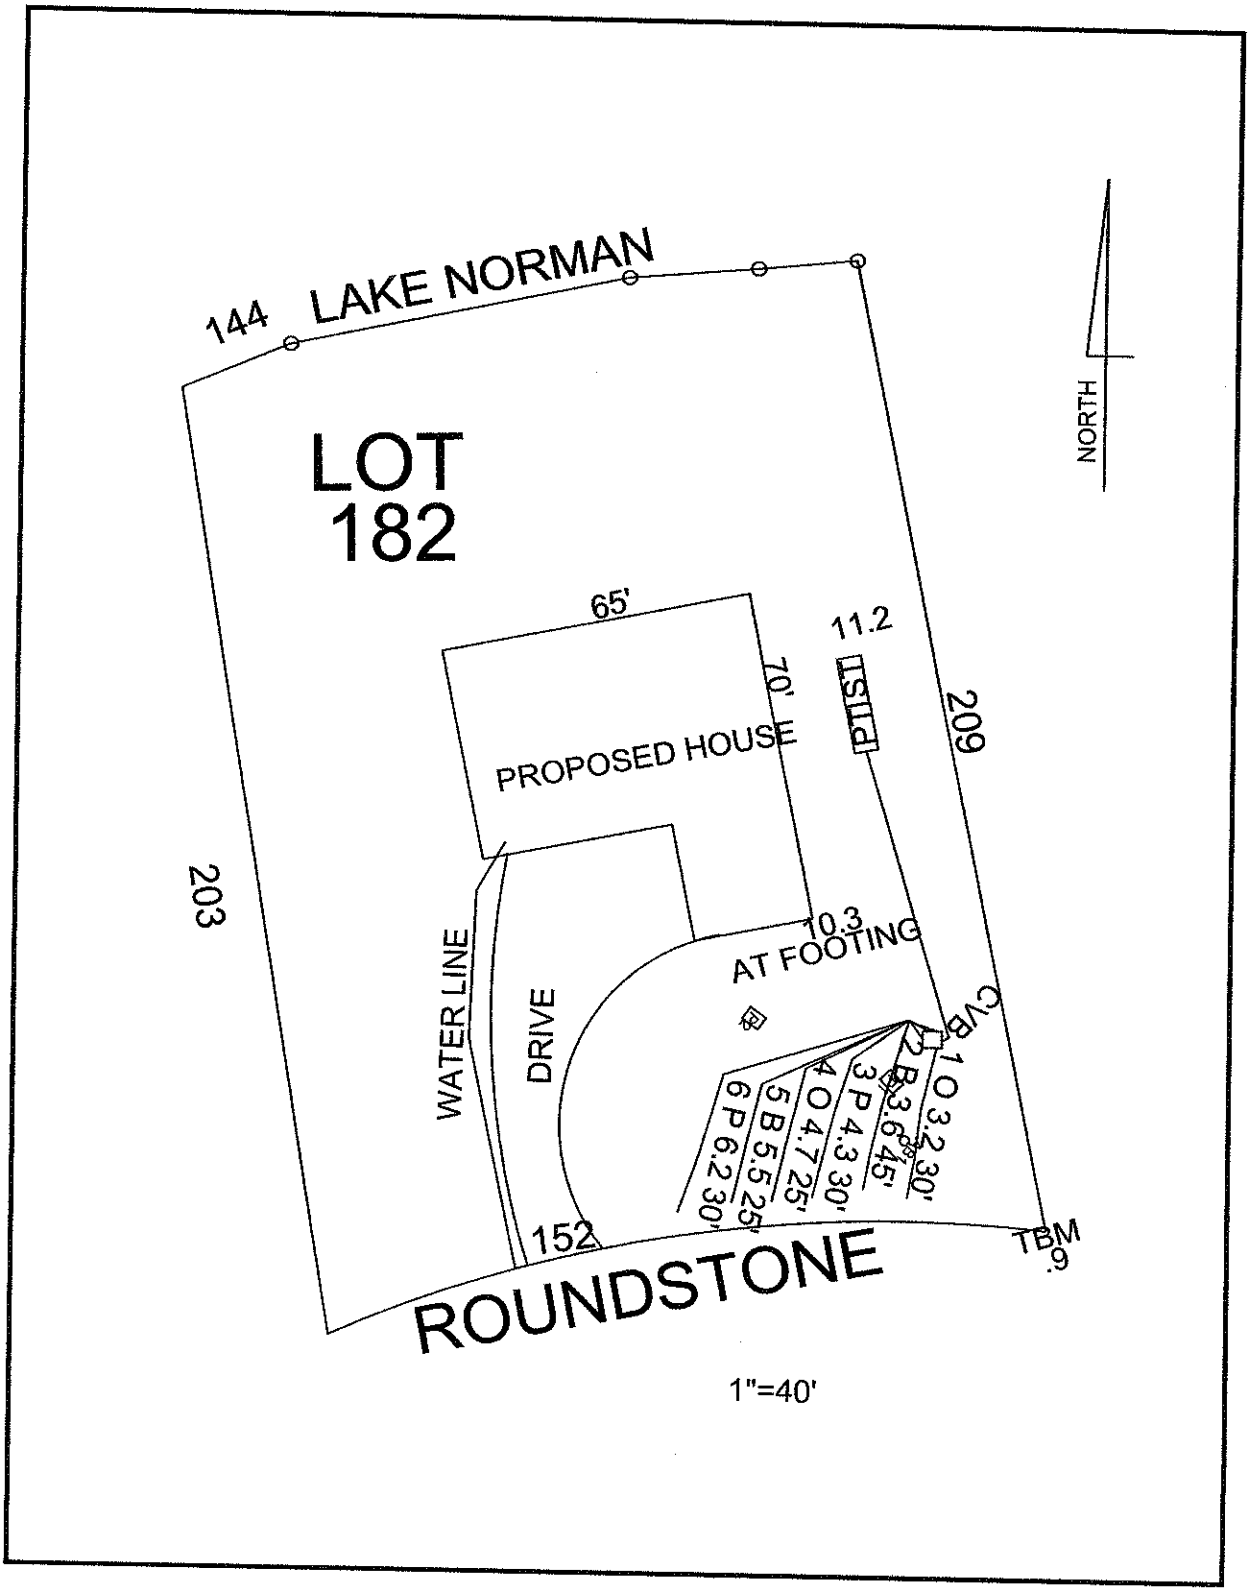
YOU SHOULD CONTACT A LOCATOR SERVICE PRIOR TO ANY EXCAVATION

Installed by: Richard Abernathy

OPERATION PERMIT by: REHS Date 25 September 11

Existing System Inspected by: REHS Date

White Copy – Environmental Health YELLOW COPY (Final) Owner / Applicant PINK COPY (Initial) Owner / Applicant


144
LAKE NORMAN
LOT
182
NORTH
65'
11.2
70'
PTIST
209
PROPOSED HOUSE
203
10.3
AT FOOTING
WATER LINE
DRIVE
CVB
1 O 3.2 30'
2 B 3.6 45'
3 P 4.3 30'
4 O 4.7 25'
5 B 5.5 25'
6 P 6.2 30'
152
TBM
.9
ROUNDSTONE
1"=40'