IREDELL COUNTY HEALTH DEPARTMENT

STATESVILLE 704-878-5305 MOORESVILLE 704-664-5281

IMPROVEMENT PERMIT / AUTHORIZATION TO CONSTRUCT / OPERATION PERMIT / EXISTING SYSTEM INSPECTION

125.00 Paid

PERMIT# ~~29810-094579~~ PIN# ~~4629641771.3~~ 4629-65-8422 DATE 9/20/01

OWNER OR CONTRACTOR PROVIDENCE DEV. PHONE: Business 367-0167 Home

ADDRESS 6707 FAIRVIEW RD, SUITE B, CHARLOTTE NC 28210

LOCATION PERTH(S) - TR STATE PARK - TL MORRISON FARM - TR ROUNDSTONE - ON LEFT

SUBDIVISION LAKEWAY ESTATES BLOCK / SECTION LOT 03 LOT AREA SITE CLASS. PS DESIGN FLOW 480GD L.T.A.R. .3680/KT2

Septic Tank: 1000 Gallons; STB 312 Date 8/29/05
Pump Tank: Gallons; PT Date
Pump Make: Model Serial No.
Nitrification Field: No Fields 1 Square Feet 1200 Linear Feet 400
No Lines 4@100' Trench Width 36" Max Trench Bottom Depth 36" Gravel Depth N/A

☑ New System ☐ Repair System Type: I, II, III, IV, V, VI
System Description: GRAVITY 25% REDUCTION
Repair System Description: LP PANEL
Maintenance Agreement Required: ☐ Yes ☑ No


☑ House/Mod. Home No. Bedrooms 4
☐ Mobile Home No. Bathrooms 4
☐ Business No. Employees
☐ Other
☐ Slab ☑ Crawl Space ☐ Basement w/plumbing ☐ Basement wo/plumbing

Water Supply: ☐ Individual ☐ Public ☑ Community


Comments:/Conditions: X Approved A 4 BEDROOM 53'X70' HOUSE PLAN, SEPTIC IS UNAFFECTED & KEEP CLR TO SEPTIC TANK. HOUSE IS PLOTTED, DRIVEWAY IS FLIPPED ALSO

Comments:/Conditions: 1) SEE PLAT FOR LOT NUMBER CHANGE
2) LOT WAS LOT 28 (SUNSET BAY)(LONG COVE) NOW LOT 3 LAKEWAY ESTATES

INITIAL SITE SKETCH 1" = 50'

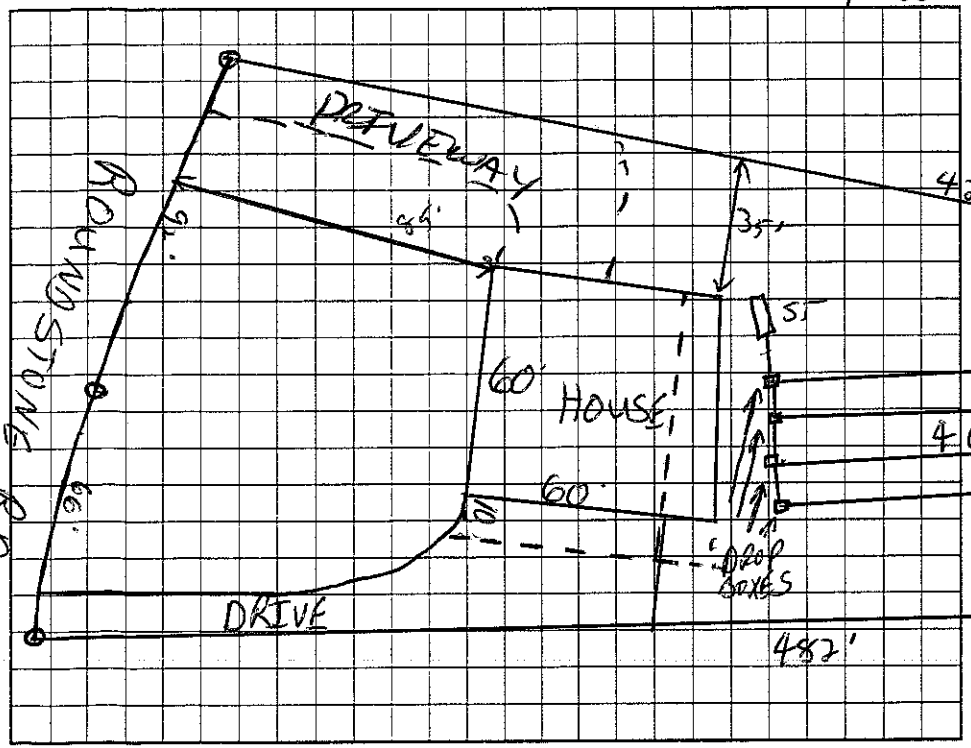

AS BUILT SKETCH

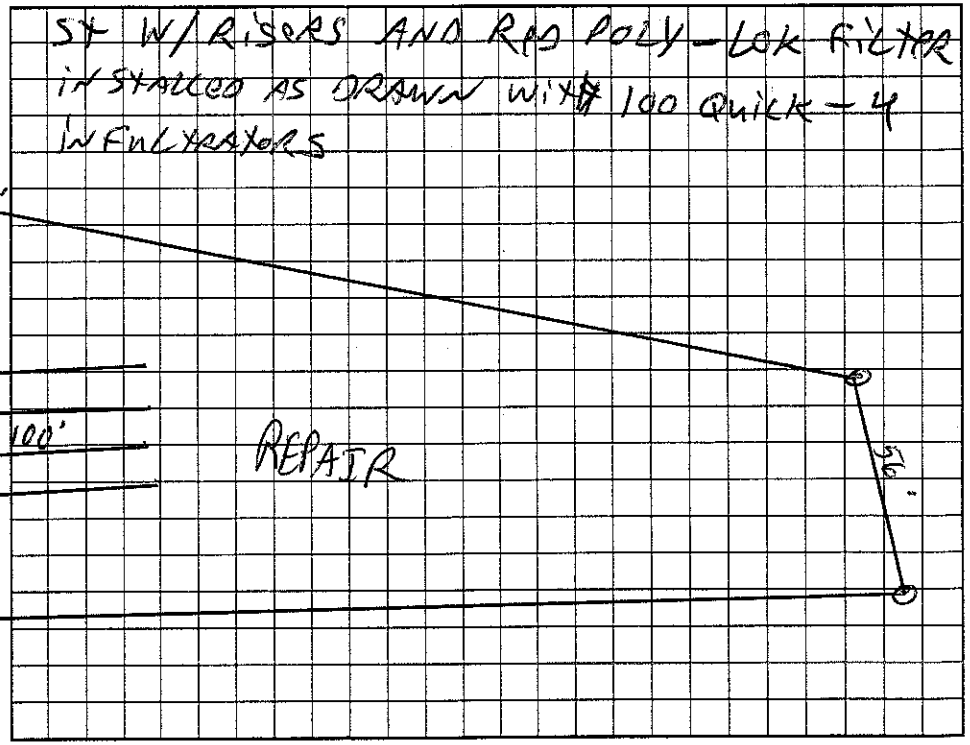

Permit can be suspended or revoked if any false information is supplied toward securing the permit/any unauthorized changes are made to the site/any unauthorized changes are made in the installation of the system. Improvement Permit with plat valid without expiration. Improvement Permit with site plan valid for sixty months. Authorization to Construct is valid for a period equal to that of Improvement Permit – not to exceed sixty months.

Signed: [signature] date 10-11-01 Installed by: PENWARDEN CONSTRUCTION

Improvement Permit by: [signature] date 9/20/01 Operation Permit by: [signature] date 10/4/05

Authorization to Construct by: [signature] date 5-2-05 Existing System Inspection by: date

HEALTH DEPT. COPY: WHITE OWNER COPY (FINAL): YELLOW OWNER COPY (INITIAL): PINK