IREDELL COUNTY HEALTH DEPARTMENT

STATESVILLE 704-878-5305 125.00 paid 125 MOORESVILLE 704-664-5281

IMPROVEMENT PERMIT / AUTHORIZATION TO CONSTRUCT / OPERATION PERMIT / EXISTING SYSTEM INSPECTION

PERMIT# 92591 PIN# 4629659776 DATE 12/15/00

OWNER OR CONTRACTOR CRESCENT RESOURCES PHONE: Business 663-6905 (JACOBS) Home

ADDRESS PO BOX 1003 CHARLOTTE NC 28201

LOCATION PERTH RD (S) - TR ~~100~~ STATE PARK - TL MORRISON FARM - TR ROUNDSTONE - 4TH ON RT

SUBDIVISION CL & T BLOCK / SECTION 17 LOT ~~150~~ 819 LOT AREA .79Ac SITE CLASS. RS DESIGN FLOW 360.00 L.T.A.R. .30.00/FT²

Septic Tank: 1000 Gallons; STB 1007 Date 12-14-04
Pump Tank: Gallons; PT Date
Pump Make: Model Serial No.
Nitrification Field: No Fields 1 Square Feet 400 Linear Feet 200
No Lines 4@50' Trench Width 24" Max Trench Bottom Depth 36" Gravel Depth N/A


☑ New System ☐ Repair System Type: I, II, III, IV, V, VI
System Description: GRAVITY PANEL
Repair System Description: DEEDED 13-4 1983
Maintenance Agreement Required: ☐ Yes ☑ No

☑ House/Mod. Home No. Bedrooms 3
☐ Mobile Home No. Bathrooms 3
☐ Business No. Employees
☐ Other
☐ Slab ☐ Crawl Space ☑ Basement w/plumbing ☐ Basement wo/plumbing

Water Supply: ☑ Individual ☐ Public ☐ Community

Comments:/Conditions: 1) KEEP SYSTEM 100' FROM ANY WELL.

INITIAL SITE SKETCH

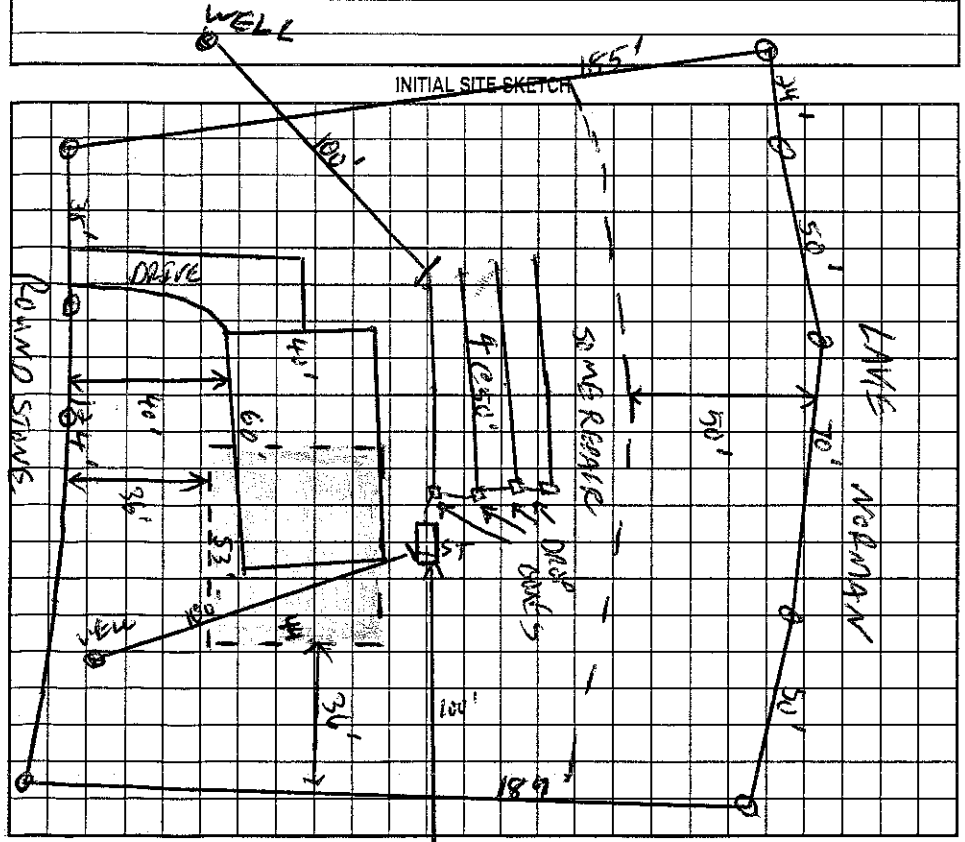

Comments:/Conditions: AC = APPROVED 5-7-04. HOUSE WILL BE 36" OFF P/L IN FRONT & 36' OFF SIDE AS DRAWN. (53'x44') SYSTEM WILL BE UNALTERED BY INITIAL L/O. THIS PLAN DOES NOT HAVE A BASEMENT

AS BUILT SKETCH

V'D	LAST	50'	LINE,	OK 5-8-05
V'D	3RD	50'	LINE	OK 5-11-05
V'D	2ND	50'	LINE	OK 5-12-05
V'D	4TH	50'	LINE	OK 4-15-05

4 DROP BOXES

Permit can be suspended or revoked if any false information is supplied toward securing the permit/any unauthorized changes are made to the site/any unauthorized changes are made in the installation of the system. Improvement Permit with plat valid without expiration. Improvement Permit with site plan valid for sixty months. Authorization to Construct is valid for a period equal to that of Improvement Permit – not to exceed sixty months.

Signed: date 12/19/00 Installed by: WAYNE CLONTZ

Improvement Permit by: RS date 12/18/00 Operation Permit by: Christopher M. Morris/REHS date 4-15-05

Authorization to Construct by: RS date 5-7-04 Existing System Inspection by: date

HEALTH DEPT. COPY: WHITE OWNER COPY (FINAL): YELLOW OWNER COPY (INITIAL): PINK