IREDELL COUNTY HEALTH DEPARTMENT

Statesville Phone TR 3-7271 Mooresville Phone NO 3-1271

PERMIT TO INSTALL SEPTIC TANK

Permit No. 375 Permit Date May 28 1971

Owner Howard Bryson Address Statesville, NC

Installed By Lackey Bros Address Stony Point, NC


Location of Property Troutman - Post Church Rd - Right on State Park Rd. Left on Road #1321 - Turn right at Power Line and bear left - end of Road 36 - 11

Tank		Capacity		Length of Lines		Fixtures	
Block	( )	1000	(✓)	225'	(✓)	No. of Baths	(1)
Precast	(✓)	1250	( )	250'	( )	Dishwasher	( )
		1500	( )	Other		Garbage Grdr.	( )
		Other				Other	

NOTIFY HEALTH DEPARTMENT AT LEAST EIGHT HOURS BEFORE TANK IS TO BE INSPECTED.

Final Inspection May 27 1971 Approved (✓) Disapproved ( )

Remarks

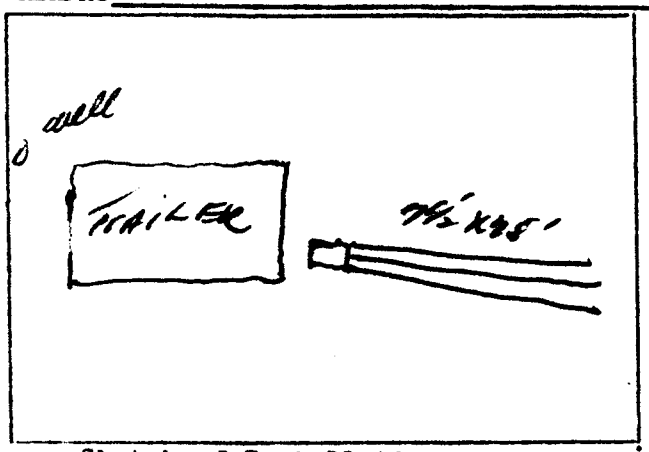

Sketch of Installation

Glenn Ford

Sanitarian