IREDELL COUNTY HEALTH DEPARTMENT

STATESVILLE 704-878-5305 MOORESVILLE 704-664-5281

IMPROVEMENT PERMIT / AUTHORIZATION TO CONSTRUCT / OPERATION PERMIT / EXISTING SYSTEM INSPECTION

PERMIT# 077957 PIN# ~~4603734550~~ 4629680556 DATE 10/29/98

OWNER OR CONTRACTOR Crescent Resources PHONE: Business 664-6905 Home

ADDRESS P.O. Box 1003 Charlotte, N.C. 28201

LOCATION State Park Rd TL Wildlife Bay, TR Sierra woods TL Deer Run

SUBDIVISION Wildlife Bay BLOCK / SECTION 1 LOT 30/30A LOT AREA SITE CLASS. PS DESIGN FLOW 450 gpd L.T.A.R. 3

Septic Tank: 1000 Gallons; STB Rotoplo Date 2-7-00
Pump Tank: 1000 Gallons; PT Rotoplo Date 1-20-00
Pump Make: Hydromatic Model SHEF50A1 Serial No Mfg. 2-08
Nitrification Field: No Fields 1 Square Feet 1200' Linear Feet 100'
No Lines 5 at 80' Trench Width 36" Max Trench Bottom Depth N/A 36" Gravel Depth N/A

[X] New System [ ] Repair System Type: I, II, III, IV, V, VI
System Description: Pump(Pm) - 25% Reduction
Repair System Description: Same
Maintenance Agreement Required: [ ] Yes [ ] No

[X] House/Mod. Home [ ] Mobile Home [ ] Business [ ] Other
No. Bedrooms 3 No. Bathrooms ___ No. Employees ___


[X] Slab [X] Crawl Space [X] Basement w/plumbing [ ] Basement w/o plumbing

Water Supply: [ ] Individual [ ] Public [X] Community

Comments:/Conditions: Keep Septic System 10' From PL + 50' from Lake.

Comments:/Conditions: Partial
3-27: ± Lines Installed As shown using HDS sections OK
3-30 Pump Pressure set OK
6-16 Alarm & Wiring OK - GR surface Mat Sediment in Pump Tank

Scale 1:100 INITIAL SITE SKETCH

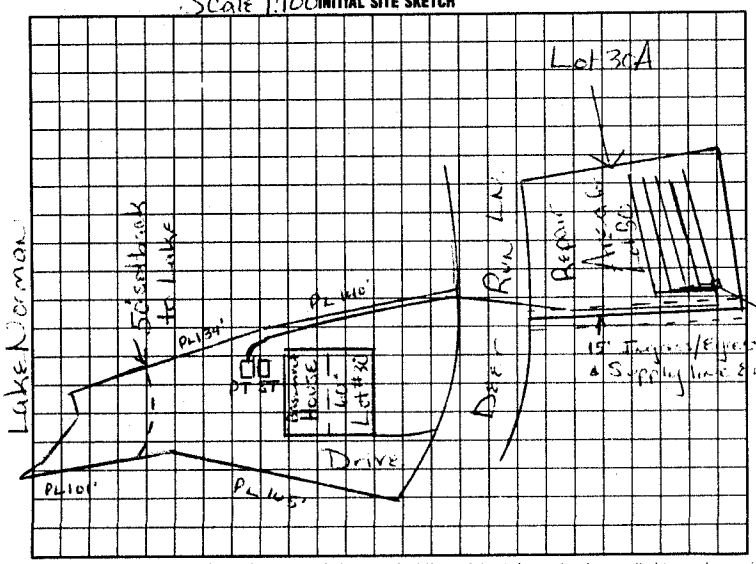

AS BUILT SKETCH

Extra Riser (18") Added To bring Top Above grade
Pump Tank has had surface H2O & sediment
Fill into it. Recommend having Pump Tank Flushed & Pumped out

I understand that this permit can be suspended or revoked if any false information is supplied toward securing the permit/any unauthorized changes are made to the site/any unauthorized changes are made in the installation of the system. Improvement Permit with plat valid without expiration. Improvement Permit with site plan valid for sixty months. Authorization to Construct is valid for a period equal to that of Improvement Permit – not to exceed sixty months.

Signed: T.C.T. date 11-23-98 Installed by: C & W Construction

Improvement Permit by: Mark Hildreth R.S. date 11/20/98 Operation Permit by: Joe Potter date June 6, 2000

Authorization to Construct by: Joe Potter date Sept 21, 99 Existing System Inspection by: ___ date ___

HEALTH DEPT. COPY: WHITE INSPECTION COPY (FINAL): GREEN OWNER COPY (FINAL): YELLOW INSPECTION COPY (INITIAL): PINK OWNER COPY (INITIAL): GOLD