IREDELL COUNTY HEALTH DEPARTMENT

STATESVILLE 704-878-5305 MOORESVILLE 704-664-5281

IMPROVEMENT PERMIT / AUTHORIZATION TO CONSTRUCT / OPERATION PERMIT / EXISTING SYSTEM INSPECTION

PERMIT# 077960 PIN# ~~4639734550~~ 4629-68-1907 DATE 12/9/98

OWNER OR CONTRACTOR Crescent Resources PHONE: Business 663-6905 Home

ADDRESS P.O. Box 1003 Charlotte NC 28201

LOCATION State Park Rd TL Wildlife Bay TR Sierra Woods TL Deer Run

SUBDIVISION Wildlife Bay BLOCK / SECTION I LOT 31/31A LOT AREA SITE CLASS. PS DESIGN FLOW 480gpd L.T.A.R. -3

Septic Tank: 1000 Gallons; STB 1007 Date 6-4-02

Pump Tank: 1000 Gallons; PT 274 Date 6-26-02

Pump Make: Zoeller Model E165-2 Serial No. —165-0004

Nitrification Field: No Fields 1 Square Feet 1200' Linear Feet 400'

No Lines 5 at 80' Trench Width 36" Max Trench Bottom Depth 36" Gravel Depth N/A

☒ New System ☐ Repair System Type: I, II, III, IV, V, VI

System Description: ~~Lot 31A~~ Offsite to Lot 31A - Pump (Dm), 25% Reduct.

Repair System Description: Offsite Pump - Panel

Maintenance Agreement Required: ☐ Yes ☒ No

☒ House/Mod. Home ☐ Mobile Home ☐ Business ☐ Other

No. Bedrooms 4 No. Bathrooms 4 No. Employees

☐ Slab ☐ Crawl Space ☒ Basement w/plumbing ☐ Basement wo/plumbing

Water Supply: ☐ Individual ☐ Public ☒ Community


Comments:/Conditions: ~~Septic~~ Septic Drainfield located offsite on Lot #31A approx 180' down Deer Run Dr from Lot #31

Comments:/Conditions: Keep Septic System at least 10' From PL & 50' from lake


(ST & PT Inspected 9/11/02 ewf - Pressure Check okay 7/28/03 ewf

Polylok filter Installed ewf) Elect Alarm - okay 12-2-03 ewf

INITIAL SITE SKETCH

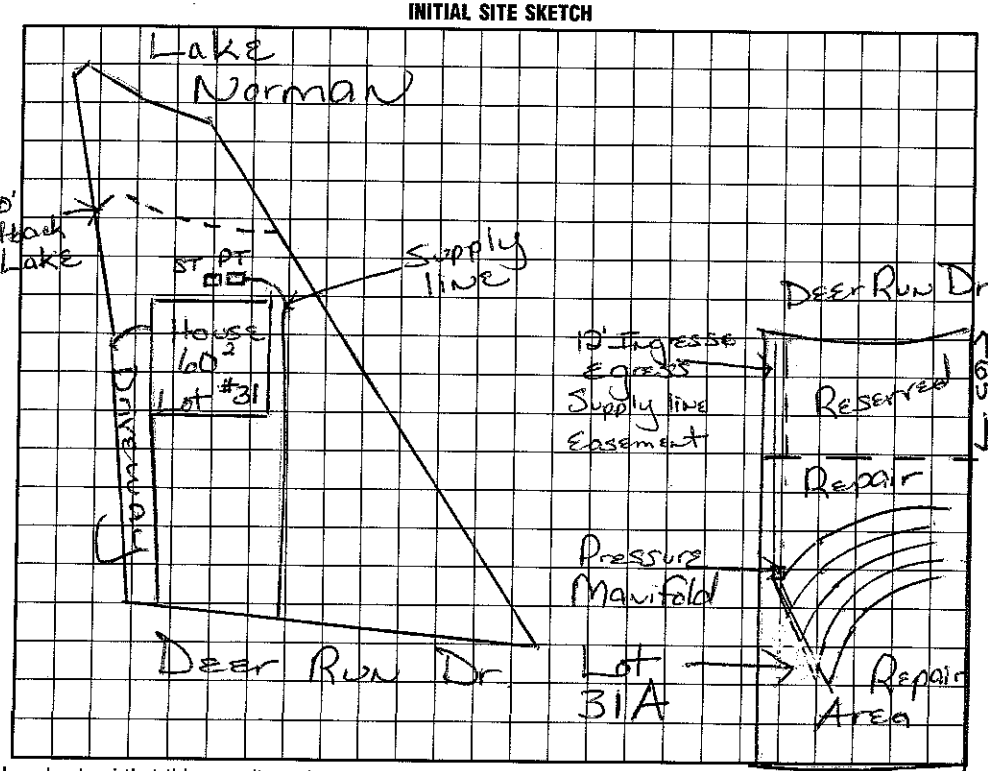

AS BUILT SKETCH

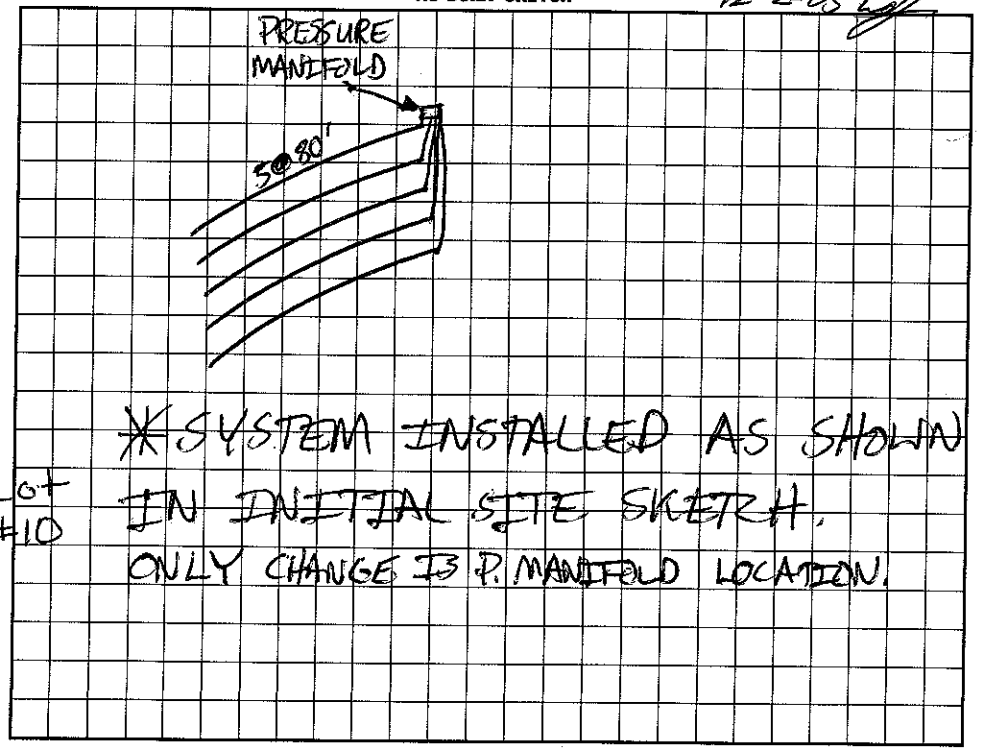

I understand that this permit can be suspended or revoked if any false information is supplied toward securing the permit/any unauthorized changes are made to the site/any unauthorized changes are made in the installation of the system. Improvement Permit with plat valid without expiration. Improvement Permit with site plan valid for sixty months. Authorization to Construct is valid for a period equal to that of Improvement Permit – not to exceed sixty months.

Signed: Tony Gaul, CPSS date 12-9-98

Improvement Permit by: Maria H. Dotson RS date 12/9/98

Authorization to Construct by: William O. Johnson date 6/24/02

Installed by: WAYNE CLONTZ (Lic. 7-21-03)

Operation Permit by: William O. Johnson date 12-2-03

Existing System Inspection by: date

HEALTH DEPT. COPY: WHITE INSPECTION COPY (FINAL): GREEN OWNER COPY (FINAL): YELLOW INSPECTION COPY (INITIAL): PINK OWNER COPY (INITIAL): GOLD