IREDELL COUNTY HEALTH DEPARTMENT

STATESVILLE 704-878-5305 MOORESVILLE 704-664-5281

IMPROVEMENT PERMIT / AUTHORIZATION TO CONSTRUCT / OPERATION PERMIT / EXISTING SYSTEM INSPECTION

PERMIT# 129261 PIN# 4629687380 DATE 2-7-06

OWNER OR CONTRACTOR Harold Cecil PHONE: Business 336 474 6385 Home 704 202 1876

ADDRESS 366 Wildlife Rd

LOCATION From 21 S take Perth, R on State Park to L on Wildlife Rd. ~ 1.5 mi. to property on right

SUBDIVISION CC&T n/a BLOCK / SECTION n/a 18 LOT n/a 13a LOT AREA .73 SITE CLASS n/a DESIGN FLOW 360 L.T.A.R. existing

Septic Tank: 1500 Gallons; STB 1014 Date

Pump Tank: existing Gallons; PT Date

Pump Make: Goulds Model WS0511BHF Serial No. F0463997

Nitrification Field: No Fields Ex. Square Feet Ex. Linear Feet Ex.

No Lines Ex. Trench Width Ex. Max Trench Bottom Depth Ex. Gravel Depth Ex.

☐ New System ☐ Repair System Type: I, II, (III), IV, V, VI

System Description: pump, conventional

Repair System Description:

Maintenance Agreement Required: ☐ Yes ☐ No

☒ House/Mod. Home No. Bedrooms 3

☐ Mobile Home No. Bathrooms

☐ Business No. Employees

☐ Other


☐ Slab ☐ Crawl Space ☒ Basement w/plumbing ☐ Basement wo/plumbing

Water Supply: ☒ Individual ☐ Public ☐ Community


Comments:/Conditions: ① Install riser extension to extend a minimun of 6" above finished grade ② Install a float tree into existing pump tank ③ Bring electrical and alarm panel up to today's standards ④ Uncover septic tank to get manufacturer and date information. Tank shall EITHER HAVE risers installed or ground graded to have acess within 6" of ground

Comments:/Conditions:

INITIAL SITE SKETCH

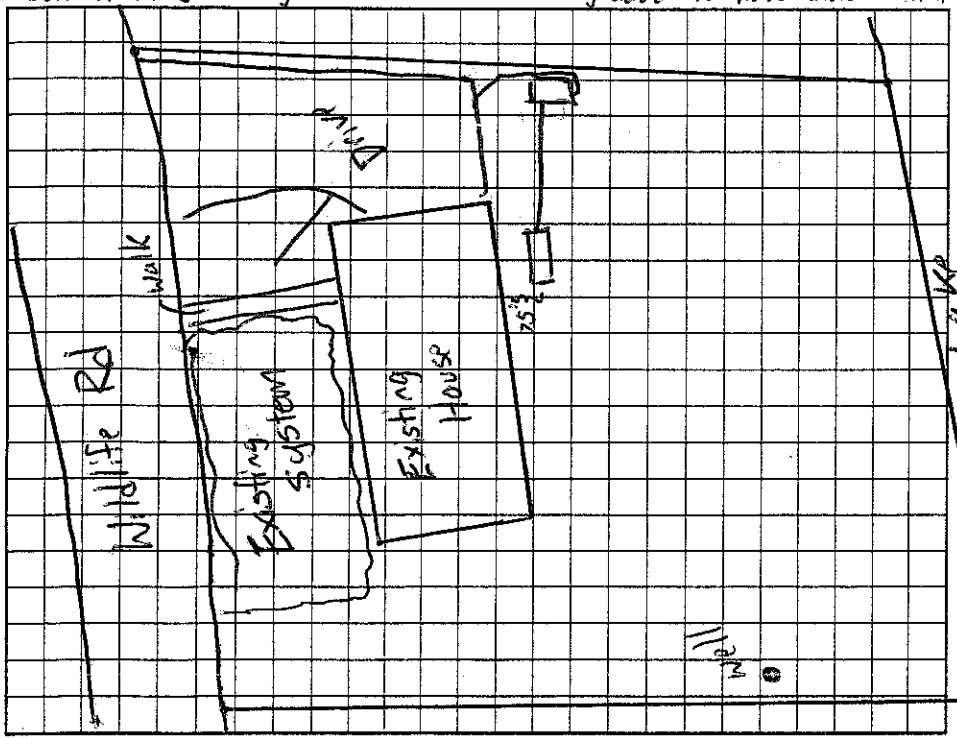

AS BUILT SKETCH

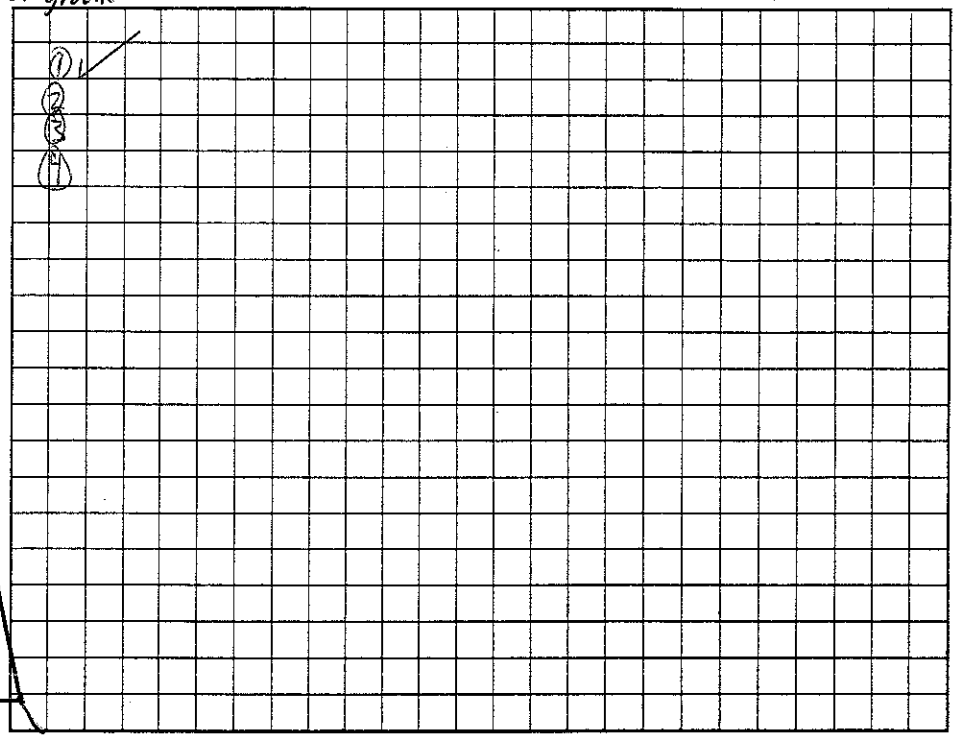

Permit can be suspended or revoked if any false information is supplied toward securing the permit/any unauthorized changes are made to the site/any unauthorized changes are made in the installation of the system. Improvement Permit with plat valid without expiration. Improvement Permit with site plan valid for sixty months. Authorization to Construct is valid for a period equal to that of Improvement Permit – not to exceed sixty months.

Signed: Harold Cecil date

Improvement Permit by: James Dunn date 2-7-06

Authorization to Construct by: James Dunn date 2-7-06

Installed by: Existing

Operation Permit by: James Dunn date 2-14-07

Existing System Inspection by: date

HEALTH DEPT. COPY: WHITE OWNER COPY (FINAL): YELLOW OWNER COPY (INITIAL): PINK