IREDELL COUNTY HEALTH DEPARTMENT

STATESVILLE 704-878-5305 CI MOORESVILLE 704-664-5281

IMPROVEMENT PERMIT / AUTHORIZATION TO CONSTRUCT / OPERATION PERMIT / EXISTING SYSTEM INSPECTION

PERMIT# 121825 PIN# 4629-69-0215 DATE 6-28-04

OWNER OR CONTRACTOR JOHN STELMACH PHONE: Business 704-408-0343 Home

ADDRESS 199000 SHEARWATER POINT CORNELIUS NC 280317

LOCATION 21 SOUTH (R) PERTH (R) STATE PARK (L) Wildlife (R) Sierra Woods (L) DEER RUN (R) EAGLE CHASE (L) HAWK RUN ON LFT

SUBDIVISION Wildlife Bay BLOCK / SECTION I LOT 35 LOT AREA 25,000 sq ft SITE CLASS. PS DESIGN FLOW 360 L.T.A.R. .3

Septic Tank: 1000 Gallons; STB 1012 Date 4-13-04

Pump Tank: Gallons; PT Date

Pump Make: Model Serial No.

Nitrification Field: No Fields 1 Square Feet EQ=1200° Linear Feet 300'

No Lines 3x100' Trench Width 36" Max Trench Bottom Depth 36" Gravel Depth N/A

☒ New System ☐ Repair System Type: I, II, (III), IV, V, VI

System Description: GRAV 25% REDUCT

Repair System Description: LP PANEL

Maintenance Agreement Required: ☐ Yes ☒ No

☐ Slab ☒ Crawl Space ☐ Basement w/plumbing ☐ Basement wo/plumbing

☒ House/Mod. Home No. Bedrooms 3

☐ Mobile Home No. Bathrooms 2

☐ Business No. Employees


☐ Other

Water Supply: ☐ Individual ☐ Public ☒ Community

Comments:/Conditions: (1) INSTALL LINES @ 36" DEEP + on contour (2) Maintain Setbacks


Comments:/Conditions: TUFFTITE FILTER + MARKER INSTALLED AS DRAWN LAST LINE HAS 2" FALL IN 100' ALLOWABLE BY RULE

INITIAL SITE SKETCH

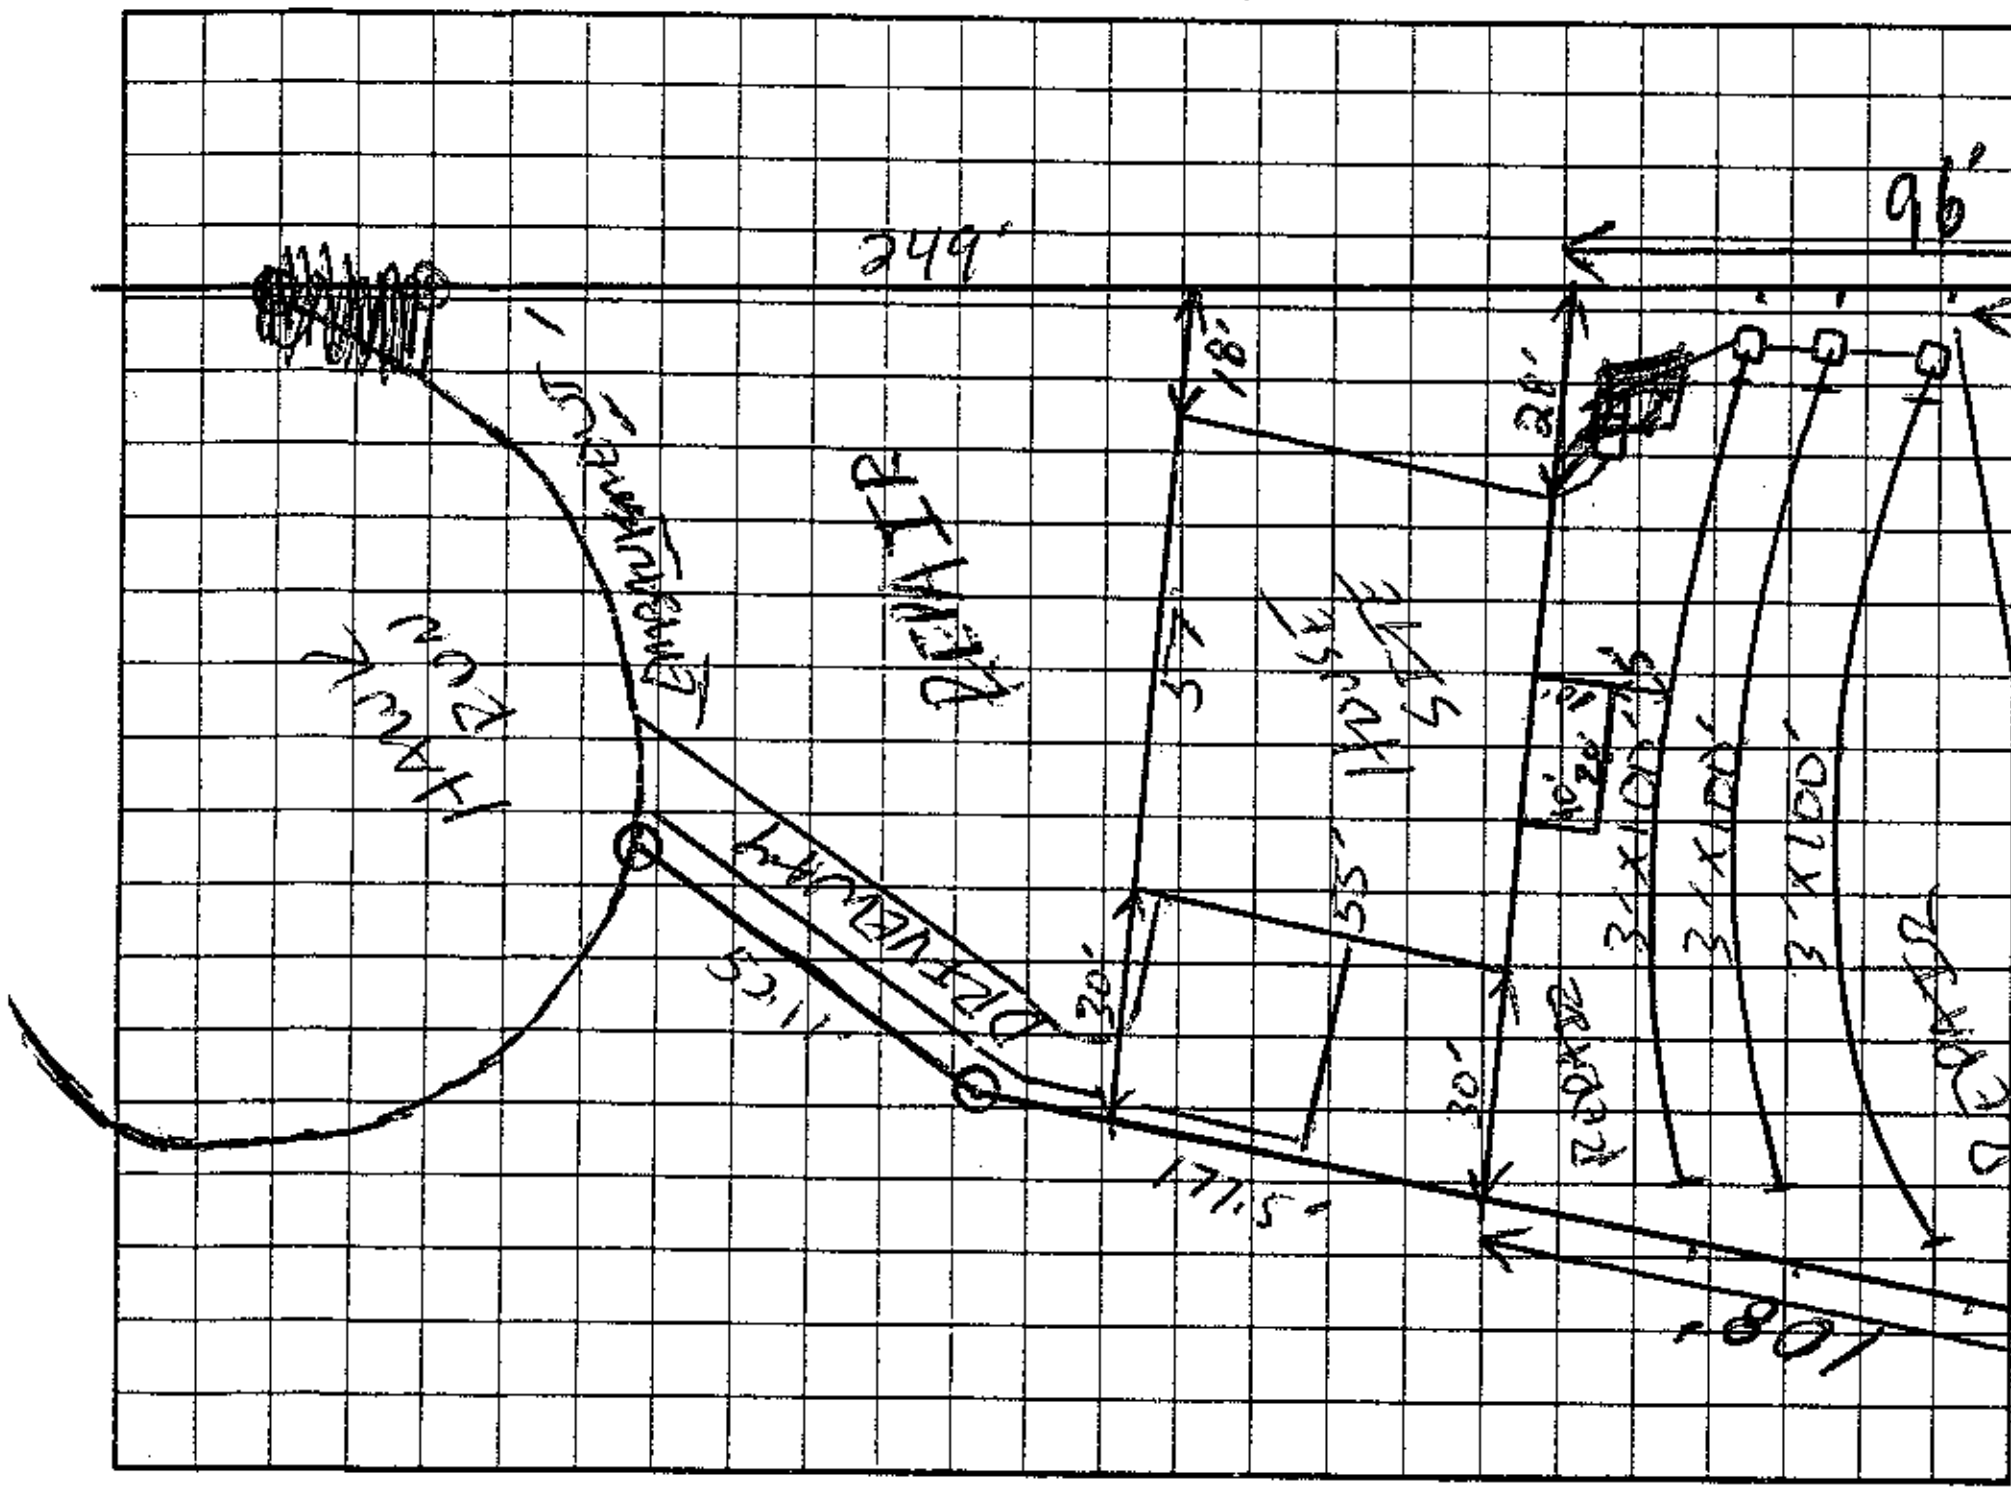

AS BUILT SKETCH

HOUSE NOT BUILT AT TIME OF CHECK, BUILDER STAKED HOUSE OFF + WORKED OFF STAKES + ALLOWED FOR 10' DECK

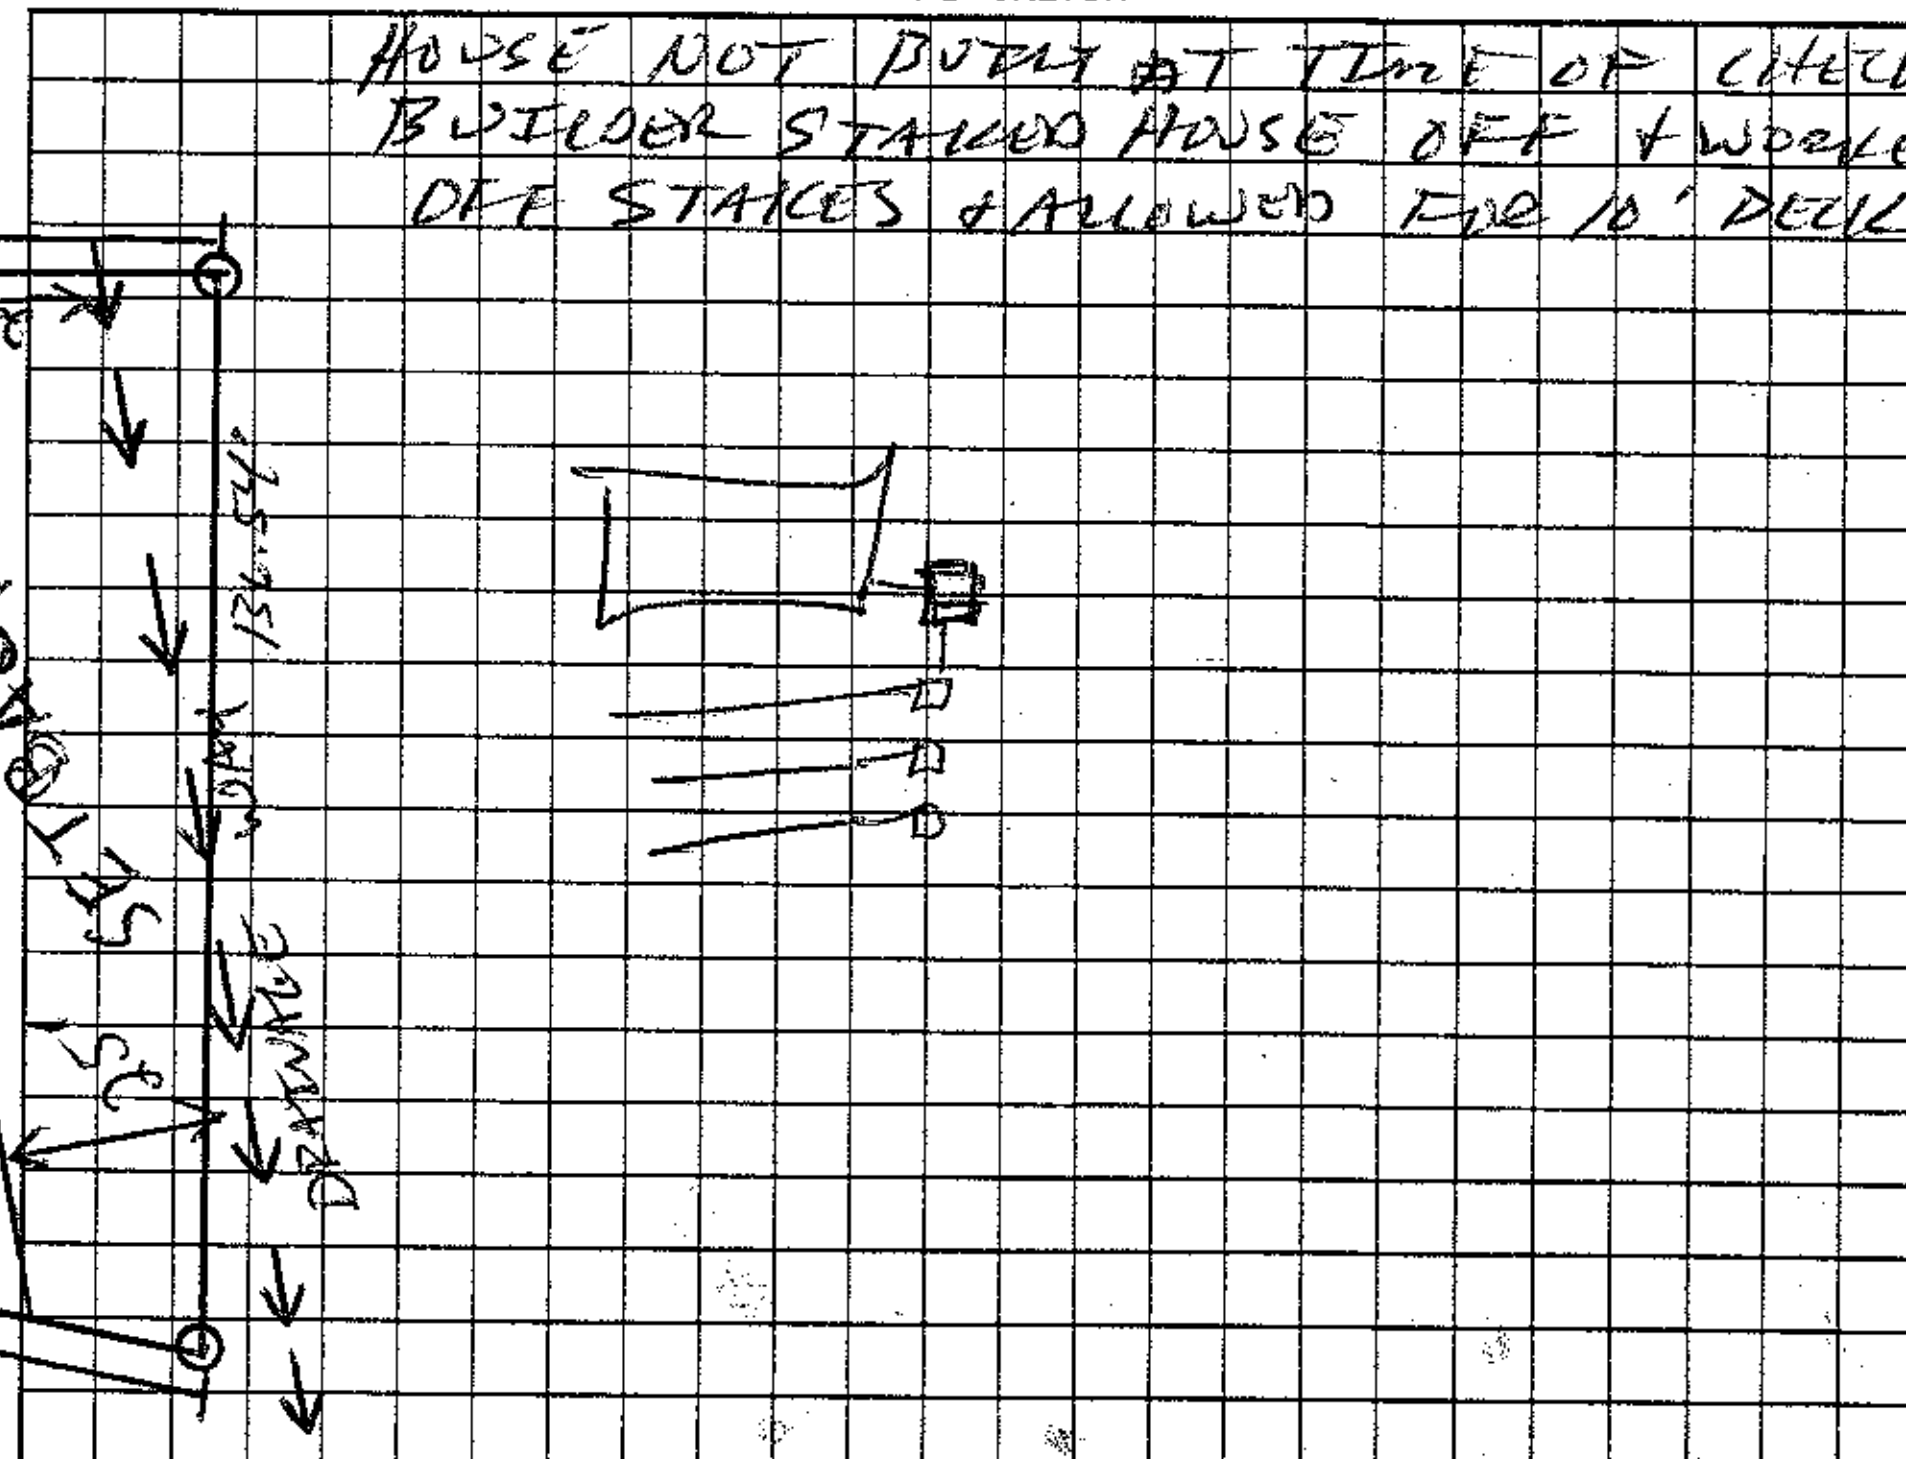

Permit can be suspended or revoked if any false information is supplied toward securing the permit/any unauthorized changes are made to the site/any unauthorized changes are made in the installation of the system. Improvement Permit with plat valid without expiration. Improvement Permit with site plan valid for sixty months. Authorization to Construct is valid for a period equal to that of Improvement Permit – not to exceed sixty months.

Signed: [signature] date 6-29-04 Installed by: TOMMY EARLE

Improvement Permit by: [signature] RS date 6-28-04 Operation Permit by: [signature] RS date 8-31-04

Authorization to Construct by: [signature] RS date 6-28-04 Existing System Inspection by: date

HEALTH DEPT. COPY: WHITE OWNER COPY (FINAL): YELLOW OWNER COPY (INITIAL): PINK