TODD ABRAMSON

IREDELL COUNTY HEALTH DEPARTMENT

This permit voids expired permit dated 10/5/98.

STATESVILLE 704-878-5305 CI of MOORESVILLE 704-664-5281

IMPROVEMENT PERMIT / AUTHORIZATION TO CONSTRUCT / OPERATION PERMIT / EXISTING SYSTEM INSPECTION

PERMIT# 074908 PIN# 4629-69-0375 DATE 12/18/03

OWNER OR CONTRACTOR Rion Homes PHONE: Business (704) 634-1488 Home —

ADDRESS 19730 Charles Towne Lane Cornelius N.C. 28031

LOCATION State Park Rd, (L) Wildlife (R) Sierra (L) Deer Run (R) Eagle Chase, (L) Hawks Run on left

SUBDIVISION Wildlife Bay BLOCK / SECTION I LOT 34 LOT AREA 26,705 sq ft SITE CLASS. PS DESIGN FLOW 360 gal L.T.A.R. - 30

Septic Tank: 1000 Gallons; STB 312 Date 3-30-03
Pump Tank: 1000 Gallons; PT 283 Date 9-28-03
Pump Make: Little Giant Model 9EHCARF Serial No.
Nitrification Field: No Fields 1 Square Feet 630 Linear Feet 210'
No Lines 3@70' Trench Width 36" Max Trench Bottom Depth 30" Gravel Depth N/A

☒ New System ☐ Repair System Type: I, II, III, ☒ V, VI
System Description: Pump, Low Pressure Panel
Repair System Description: Same
Maintenance Agreement Required: ☑ Yes ☐ No

☒ House/Mod. Home No. Bedrooms 3
☐ Mobile Home No. Bathrooms 3
☐ Business No. Employees
☐ Other


☐ Slab ☐ Crawl Space ☒ Basement w/plumbing ☐ Basement wo/plumbing

Water Supply: ☐ Individual ☒ Public ☐ Community

Comments:/Conditions: ① Keep Septic System min 10' from L and 5ft from House ② See Attachment "A" ③ A contract shall be executed between the System owner and a management entity prior to the issuance of an operation permit.


Comments:/Conditions: ① Septic Tank ~~Pumped~~ w/ marker ~~Installed~~ using Zabel filter 11-5-03 RSH ② Tanks + drainlines inspected 11-5-03 RSH – pressure check, Electrical + Alarm okay 12/18/03

INITIAL SITE SKETCH

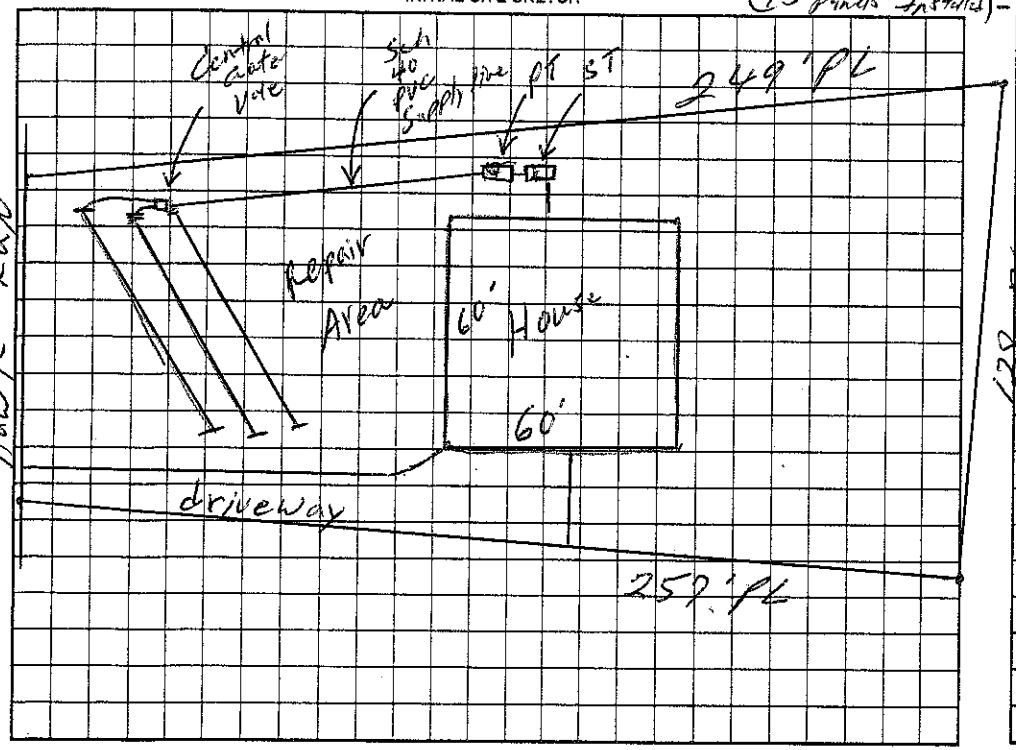

(45 panels Installed) – 5/32" Holes per Panel

AS BUILT SKETCH

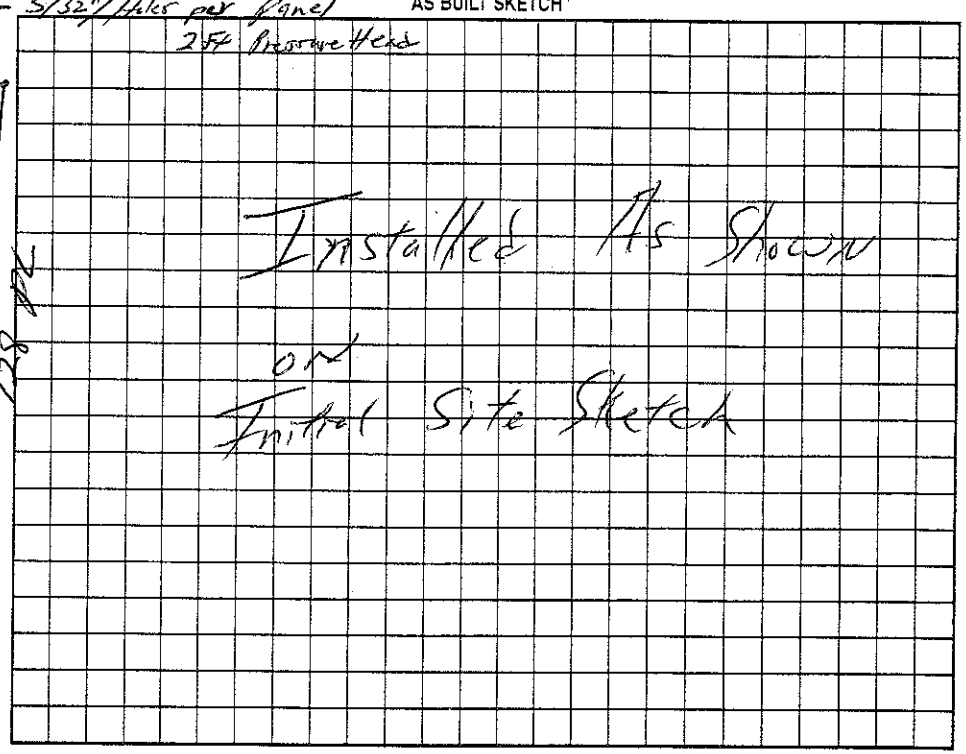

Permit can be suspended or revoked if any false information is supplied toward securing the permit/any unauthorized changes are made to the site/any unauthorized changes are made in the installation of the system. Improvement Permit with plat valid without expiration. Improvement Permit with site plan valid for sixty months. Authorization to Construct is valid for a period equal to that of Improvement Permit – not to exceed sixty months.

Signed: [signature] date 12/18/03 Installed by: Richard Abernathy

Improvement Permit by: William O. Johnson date 12/18/03 Operation Permit by: William O. Johnson date 12/18/03

Authorization to Construct by: William O. Johnson date 12/18/03 Existing System Inspection by: date

HEALTH DEPT. COPY: WHITE OWNER COPY (FINAL): YELLOW OWNER COPY (INITIAL): PINK