42 2' 23 135 gal sewage

* This permit replaces permit # 074581, that is now void

IREDELL COUNTY HEALTH DEPARTMENT

STATESVILLE 704-878-5305 Of MOORESVILLE 704-664-5281

IMPROVEMENT PERMIT / AUTHORIZATION TO CONSTRUCT / OPERATION PERMIT / EXISTING SYSTEM INSPECTION

PERMIT# 119229 PIN# 4629-69-0818 DATE 3/25/04

OWNER OR CONTRACTOR Rion Homes (Nicole Cooksby) PHONE: Business (704) 634-1488

ADDRESS 19730 Charlestown Ln Cornelius 28031 Home (704) 895-8479

LOCATION State Park Rd (L) Wildlife (R) Sierra Woods (L) Deer Run (R) Eagle Chase on (R)

SUBDIVISION Wildlife Bay BLOCK / SECTION F LOT 66 LOT AREA 1.03 SITE CLASS. A DESIGN FLOW 360 L.T.A.R. .25 gpd/ft²

Septic Tank: 1000 Gallons; STB 312 Date 7-16-04

Pump Tank: 1000 Gallons; PT 283 Date 5-11-04

Pump Make: [illegible] Model [illegible] Serial No. [illegible]

Nitrification Field: No Fields 1 Square Feet 1440 Linear Feet 240

No Lines 5 Trench Width 24" Max Trench Bottom Depth 30

☑ New System ☐ Repair System Type: I, II, III, IV, V, VI

System Description: LP Panel 50% Red.

Repair System Description: LP Panel 50% Red.

Maintenance Agreement Required: ☑ Yes ☐ No

☑ House/Mod. Home No. Bedrooms 3

☐ Mobile Home No. Bathrooms 2.5

☐ Business No. Employees

☐ Other

Water Supply: ☐ Individual ☑ Public ☑ Community


Gravel Depth 24" Sand ☐ Slab ☑ Crawl Space ☐ Basement w/plumbing ☐ Basement wo/plumbing

Comments/Conditions: (1) Install lines @ 30" on contour and according to sketch (2) Must pack and fill rill gullies (3) Maintain all setbacks (4) Install tanks as shown on sketch.


Comments/Conditions: SYSTEM 10'+ OFF MAIN'D P/L & SUPPLY 5' OFF DOLVLOK FILTER & REPAIRS MAIN'D P/L NEEDS PRESSURE & ELECTRICAL V'D ELECTRICAL & PUMP SIZE. USED 54 m/sump EVERYTHING OK LC

Scale 1" = 50'

INITIAL SITE SKETCH

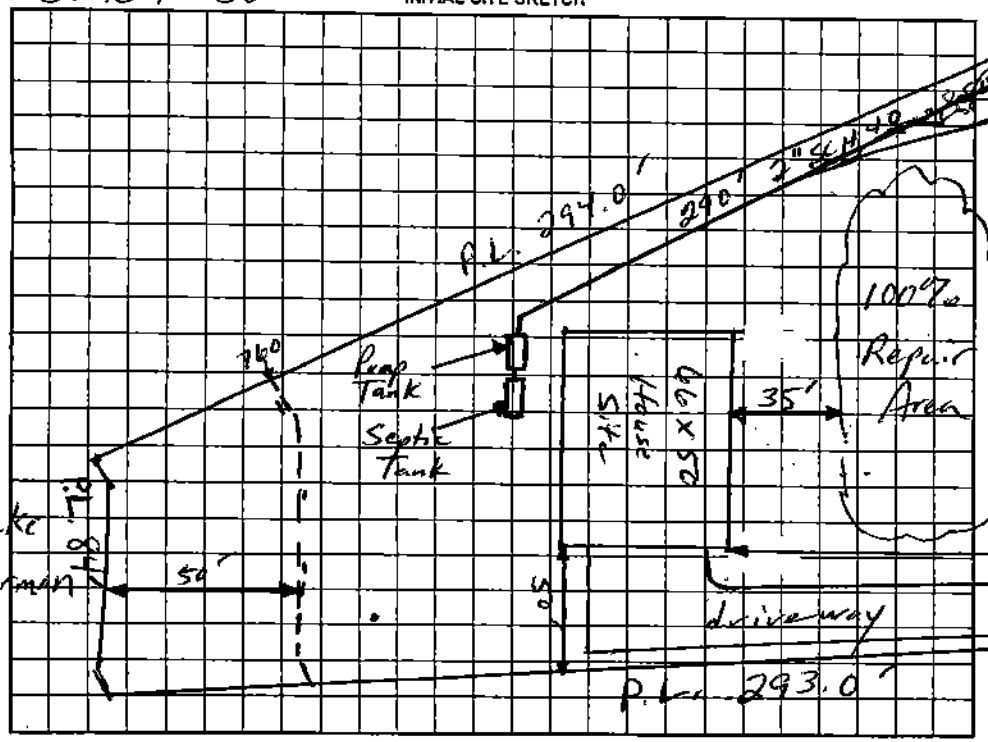

AS BUILT SKETCH

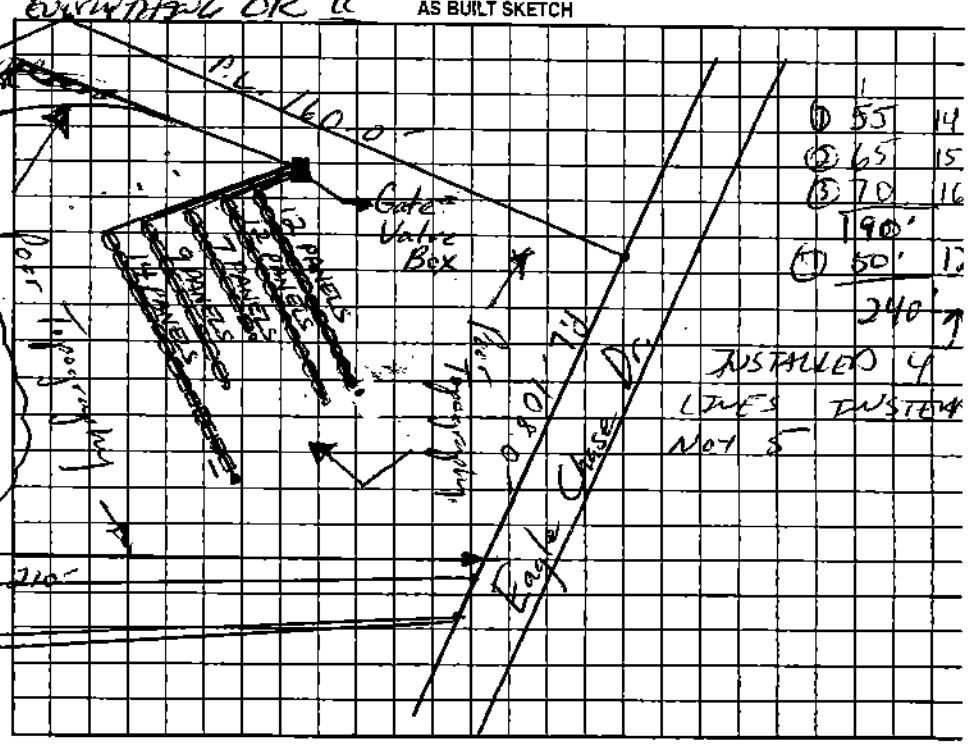

Permit can be suspended or revoked if any false information is supplied toward securing the permit/any unauthorized changes are made to the site/any unauthorized changes are made in the installation of the system. Improvement Permit with plat valid without expiration. Improvement Permit with site plan valid for sixty months. Authorization to Construct is valid for a period equal to that of Improvement Permit – not to exceed sixty months.

Signed: Nicole R. Cooksby date 4-2-04

Improvement Permit by: Christopher M. Sheild, RS date 3-25-04

Authorization to Construct by: Christopher M. Sheild, RS date 3-25-04

Installed by: ASBOWATTY 9-30-04

Operation Permit by: [signature] RS date 9-30-04

Existing System Inspection by: date

HEALTH DEPT. COPY: WHITE OWNER COPY (FINAL): YELLOW OWNER COPY (INITIAL): PINK