Notice: This permit voids previously issued permit dated 10/8/98.

IREDELL COUNTY HEALTH DEPARTMENT

STATESVILLE 704-878-5305 CJ MOORESVILLE 704-664-5281

IMPROVEMENT PERMIT / AUTHORIZATION TO CONSTRUCT / OPERATION PERMIT / EXISTING SYSTEM INSPECTION

PERMIT# 074907 PIN# ~~4639734550 PF~~ 4629-69-1157 DATE 4/3/02

OWNER OR CONTRACTOR Crescent Resources / John Preston PHONE Business (704) 896-9886 Home

ADDRESS ~~P.O. Box~~ 18716 W. Catawba Ave Suite 370 Cornelius N.C. 28031

LOCATION State Park Rd, (L) Wildlife, (R) Sierra Woods, (L) Deer Run just past Eagle Chase

SUBDIVISION Wildlife Bay BLOCK / SECTION I LOT 32 LOT AREA 1.01 Acres SITE CLASS P.S DESIGN FLOW 480gal L.T.A.R. .3

Septic Tank: 1,000 Gallons; STB 1007 Date 4-17-03

Pump Tank: 1,000 Gallons; PT ____ Date ____

Pump Make: ____ Model ____ Serial No. ____

Nitrification Field: No Fields 1 Square Feet ~~1680~~ 1680 Linear Feet 405

No Lines 4 Trench Width 36" Max Trench Bottom Depth 30" Gravel Depth N/A

[X] New System [ ] Repair System Type: I, II, III, IV, V, VI

System Description: Gravity, 25% Reduction

Repair System Description: Pump 25% Reduction

Maintenance Agreement Required: [ ] Yes [X] No

[X] House/Mod. Home No. Bedrooms 4

[ ] Mobile Home No. Bathrooms 3

[ ] Business No. Employees ____

[ ] Other ____

[ ] Slab [ ] Crawl Space [X] Basement w/plumbing [ ] Basement wo/plumbing


Water Supply: [ ] Individual [X] Public [ ] Community

Comments/Conditions: (1) Install Septic liner on contour (3) Install 25% Reduction System -44 HOES Section of 65 chambers (3) Maintain proper Setback 5


Comments/Conditions: 1st + 2nd Line checked 9/29/03 - Tuf-Tite filter + S.T. Maker Installed -66 Bio diffuser Chambers Installed

1" = 50'

INITIAL SITE SKETCH

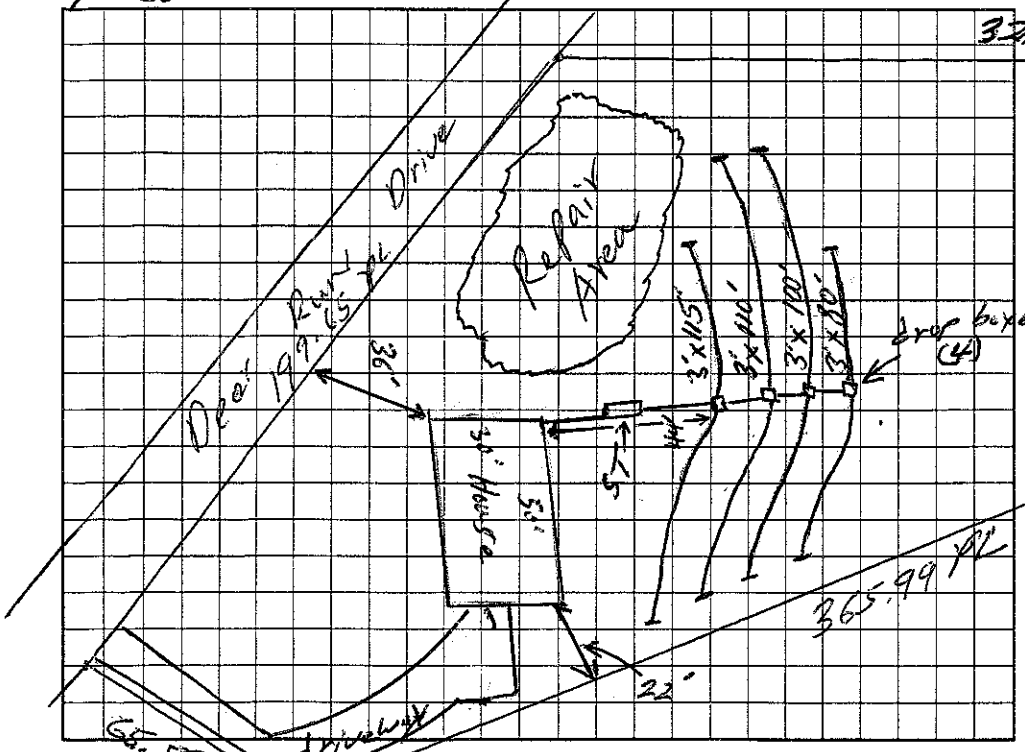

AS BUILT SKETCH

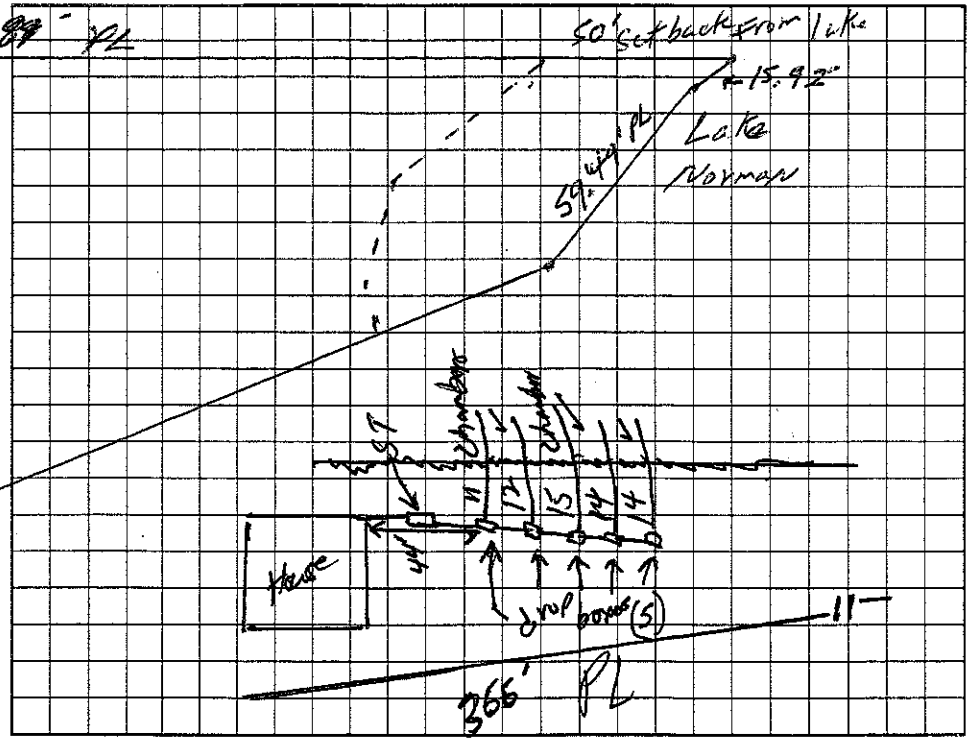

Permit can be suspended or revoked if any false information is supplied toward securing the permit/any unauthorized changes are made to the site/any unauthorized changes are made in the installation of the system. Improvement Permit with plat valid without expiration. Improvement Permit with site plan valid for sixty months. Authorization to Construct is valid for a period equal to that of Improvement Permit – not to exceed sixty months.

Signed: Randy Wellborn date 4/5/02 Installed by: Wayne Clontz

Improvement Permit by: William O. Johnson date 4/3/02 Operation Permit by: William O. Johnson date 7/29/03

Authorization to Construct by: William O. Johnson date 4/3/02 Existing System Inspection by: ____ date ____

HEALTH DEPT. COPY: WHITE OWNER COPY (FINAL): YELLOW OWNER COPY (INITIAL): PINK