IREDELL COUNTY HEALTH DEPARTMENT

CT STATESVILLE 704-878-5305 130.00 Paid MOORESVILLE 704-664-5281

IMPROVEMENT PERMIT / AUTHORIZATION TO CONSTRUCT / OPERATION PERMIT / EXISTING SYSTEM INSPECTION

PERMIT# 126764 PIN# 4629692903 DATE 3/23/05

OWNER OR CONTRACTOR LEONARD WILSON PHONE: Business 622-2323 Home

ADDRESS PO BOX 85 DAVIDSON, NC 28036

LOCATION PERTH(S)- TR STATE PARK - TL WILDLIFE RD - TR INTO WILDLIFE BAY - TL DEER RUN - ON RT

SUBDIVISION WILDLIFE BAY BLOCK / SECTION I LOT 68 LOT AREA 1.243 AC SITE CLASS. PS DESIGN FLOW 360GPD L.T.A.R. .360/RP

Septic Tank: 1000 Gallons; STB TOL Date 4-4-05
Pump Tank: Gallons; PT Date
Pump Make: Model Serial No.
Nitrification Field: No Fields 1 Square Feet 400 Linear Feet 200
No Lines 4@50' Trench Width 24" Max Trench Bottom Depth 36" Gravel Depth N/A

☑ New System ☐ Repair System Type: I, II, (III), IV, V, VI
System Description: GRAVITY PANEL
Repair System Description: PUMP 25% REDUCTION
Maintenance Agreement Required: ☐ Yes ☑ No

☑ House/Mod. Home No. Bedrooms 3
☐ Mobile Home No. Bathrooms -
☐ Business No. Employees
☐ Other


☐ Slab ☑ Crawl Space ☐ Basement w/plumbing ☐ Basement wo/plumbing

Water Supply: ☐ Individual ☐ Public ☑ Community

Comments:/Conditions:


1"=50'

INITIAL SITE SKETCH

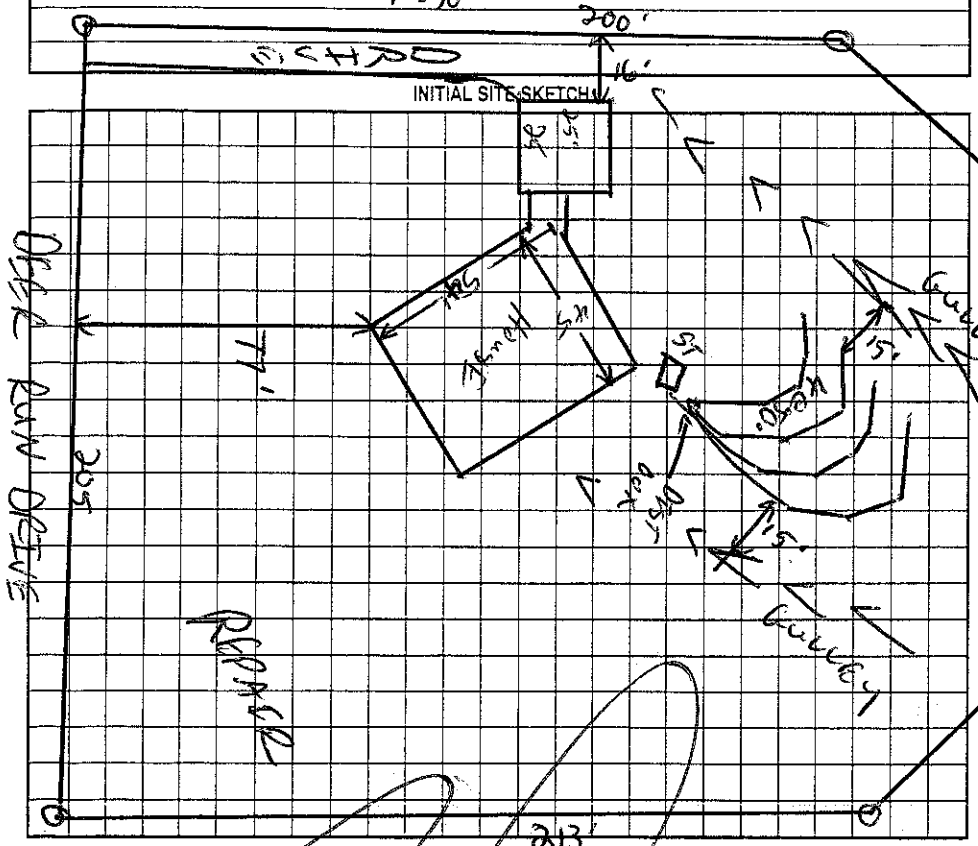

Comments:/Conditions: TUFFTITE ELBOW + ELBOWS
V'D LINES, DO TO INITIAL L/O NOT FITTING
INSTALLED 40', 50', 55', 55' = 200' USING PIPE BOX'S
WITH SPEED LEVELERS FED LIKE DROP BOXES. L/O 6-17-05

AS BUILT SKETCH

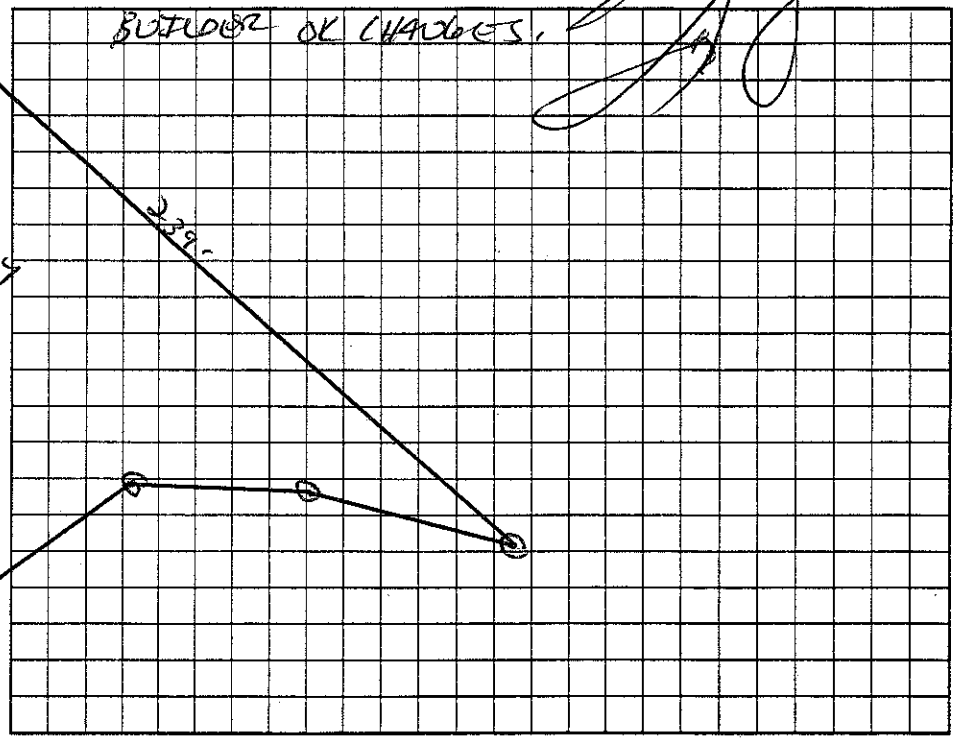

Permit can be suspended or revoked if any false information is supplied toward securing the permit/any unauthorized changes are made to the site/any unauthorized changes are made in the installation of the system. Improvement Permit with plat valid without expiration. Improvement Permit with site plan valid for sixty months. Authorization to Construct is valid for a period equal to that of Improvement Permit – not to exceed sixty months.

Signed: date 05/27/05 Installed by: STEVE JORDAN

Improvement Permit by: C. Boyce RS date 3/23/05 Operation Permit by: date 6-17-05

Authorization to Construct by: C. Boyce RS date 3/23/05 Existing System Inspection by: date

HEALTH DEPT. COPY: WHITE OWNER COPY (FINAL): YELLOW OWNER COPY (INITIAL): PINK