* THIS PERMIT VOIDS PERMIT PREVIOUSLY ISSUED ON 08/23/02

IREDELL COUNTY HEALTH DEPARTMENT

STATESVILLE 704-878-5305 (I) MOORESVILLE 704-664-5281

IMPROVEMENT PERMIT / AUTHORIZATION TO CONSTRUCT / OPERATION PERMIT / EXISTING SYSTEM INSPECTION

PERMIT# 074878 PIN# ~~4639-73-4550~~ 4629-69-4201 DATE 11/06/02

OWNER OR CONTRACTOR CHARLES V. DAVIDSON PHONE: Business 704-987-0490 Home 704-528-0543

ADDRESS 135 ANCHOR LN TROUTMAN, NC 28166

LOCATION STATE PARK RD., (L) WILDLIFE, (R) SIERRA, (L) DEER RUN, 12th LOT ON LEFT ~0.2 MILES

SUBDIVISION WILDLIFE BAY BLOCK / SECTION 1 LOT 12 LOT AREA 0.57 ACRES SITE CLASS. PS DESIGN FLOW 360 GPD L.T.A.R. 0.30 GPD/FT²

Septic Tank: 1,000 Gallons; STB 825 Date 4-9-03
Pump Tank: ____ Gallons; PT ____ Date ____
Pump Make: ____ Model ____ Serial No. ____
Nitrification Field: No Fields 1 Square Feet EQ to 1,200 Linear Feet 200
No Lines 4@50' Trench Width 24" Max Trench Bottom Depth 36"

[X] New System [ ] Repair System Type: I, II, (III), IV, V, VI
System Description: 50% REDUCTION, GRAVITY
Repair System Description: LOW PRESSURE, 50% REDUC.
Maintenance Agreement Required: [ ] Yes [ ] No
Gravel Depth N/A [ ] Slab [ ] Crawl Space


[X] House/Mod. Home No. Bedrooms 3
[ ] Mobile Home No. Bathrooms 2.5
[ ] Business No. Employees ____
[ ] Other ____
Basement w/plumbing [X] Basement wo/plumbing

Water Supply: [ ] Individual [X] Public [ ] Community


Comments:/Conditions: (1) INSTALL SYSTEM USING 11 PANELS PER LINE (44 TOTAL) (2) MAINTAIN ALL SETBACKS, INCLUDING SETBACKS FROM BASEMENT CUTT (10' DOWNSLOPE, 15' SIDE, 25' UPSLOPE) (3) CALL PRIOR TO INSTALLATION FOR [redacted] CONSULTATIVE VISIT.

Comments:/Conditions: Poly Lok Filter Installed

INITIAL SITE SKETCH

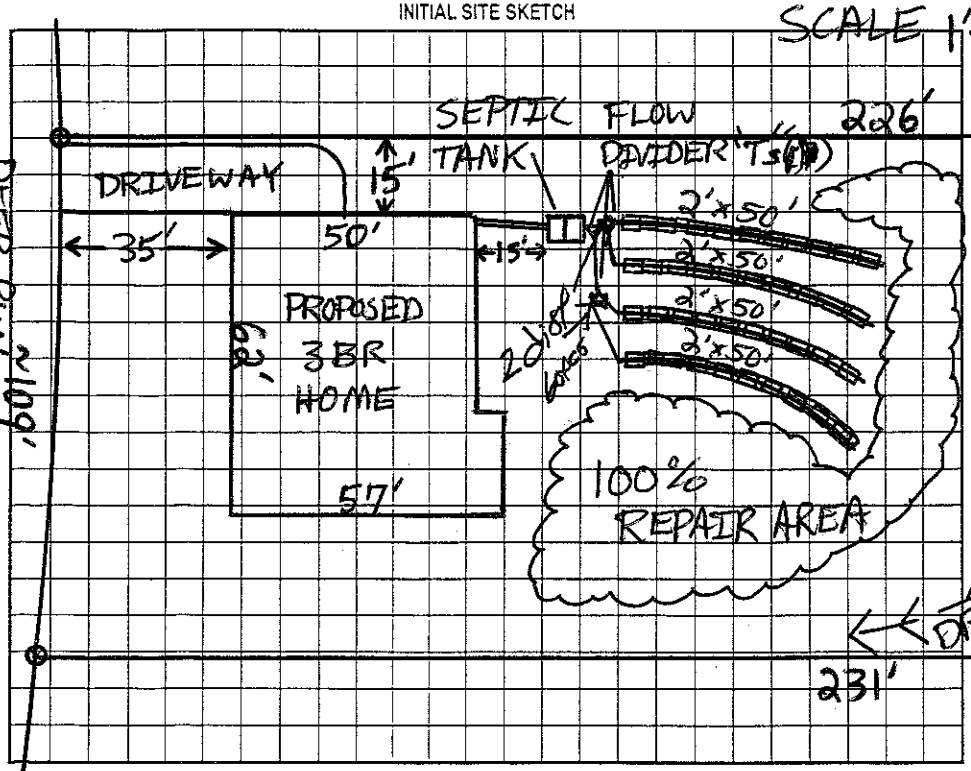

AS BUILT SKETCH

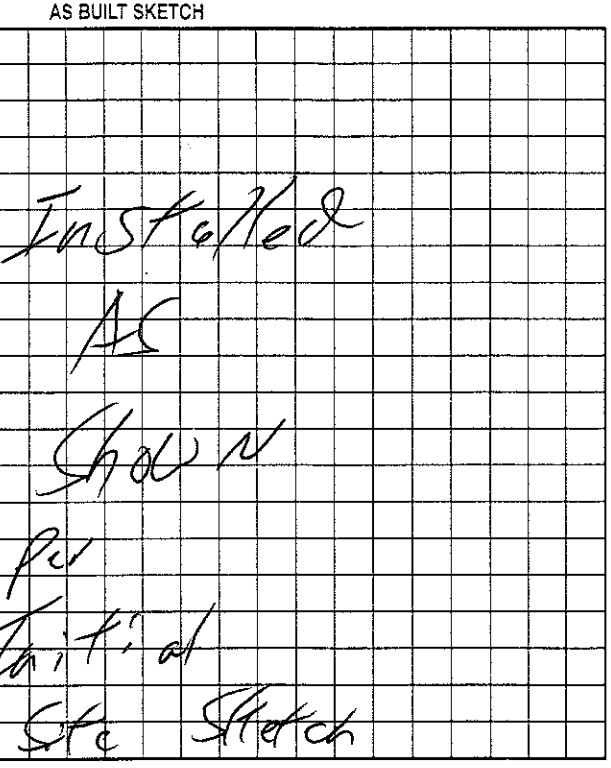

Permit can be suspended or revoked if any false information is supplied toward securing the permit/any unauthorized changes are made to the site/any unauthorized changes are made in the installation of the system. Improvement Permit with plat valid without expiration. Improvement Permit with site plan valid for sixty months. Authorization to Construct is valid for a period equal to that of Improvement Permit – not to exceed sixty months.

Signed: Angela L. Mundy date 11/8/02 Installed by: Rowan Septic

Improvement Permit by: Patrick Mitchell date 11/06/02 Operation Permit by: William O. Johnson date 8/18/03

Authorization to Construct by: Patrick Mitchell date 11/06/02 Existing System Inspection by: ____ date ____

HEALTH DEPT. COPY: WHITE OWNER COPY (FINAL): YELLOW OWNER COPY (INITIAL): PINK