THIS PERMIT VOIDS PREVIOUS PERMIT, ISSUED 10-21-01 (1)

IREDELL COUNTY HEALTH DEPARTMENT

STATESVILLE 704-878-5305 MOORESVILLE 704-664-5281

IMPROVEMENT PERMIT / AUTHORIZATION TO CONSTRUCT / OPERATION PERMIT / EXISTING SYSTEM INSPECTIO

PERMIT# 074876 134692 PIN# 4639-73-4550 (T) 4629 69 4523 DATE 05/01/03

OWNER OR CONTRACTOR SCOTT BROERMAN Pride Homes PHONE: Business Home 704-838-7055

ADDRESS ~~119 KOKODEE DR~~ MOORESVILLE, NC 28117 4207 Barrwood Trail, Denver

LOCATION STATE PARK RD., (L) WILDLIFE, (R) SIERRA, (L) DEER RUN, 9th LOT ON LEFT.

SUBDIVISION WILDLIFE BAY BLOCK / SECTION I LOT 4 LOT AREA ~0.59 ACRES SITE CLASS. PS DESIGN FLOW 480 GPD L.T.A.R. 0.30 GPD/

Septic Tank: 1,000 Gallons; STB 1012 Date 3-19-06

Pump Tank: 1,000 Gallons; PT 17 Date 11-21-05

Pump Make: Model Serial No.

Nitrification Field: No Fields 1 Square Feet EQ to 1,600 Linear Feet 280'

No Lines 4 @ 70' Trench Width 24" Max Trench Bottom Depth 30" Gravel Depth N/A

[X] New System ☐ Repair System Type: I, II, III, IV, V, VI

System Description: LOW PRESSURE, 50% REDUC.

Repair System Description: SAME

Maintenance Agreement Required: [X] Yes ☐ No

[X] House/Mod. Home No. Bedrooms 4

☐ Mobile Home No. Bathrooms 3

☐ Business No. Employees

☐ Other

☐ Slab [X] Crawl Space ☐ Basement w/plumbing ☐ Basement wo/plumbing

Water Supply: ☐ Individual [X] Public [X] Communit


Comments/Conditions: (1) INSTALL SYSTEM USING 16 PANELS PER LINE (USING 64 PANELS TOTAL TO EQUAL 280'), (2) CALL PRIOR TO INSTALLATION FOR SYSTEM TO BE REFLAGGED & FOR PUMP/LOW PRESSURE INFO. IF NEEDED, (3) 30" TRENCH BOTTOM

Comments/Conditions:


Symtec Filter Pump Tank

Yellow Jacket Lateral Line

INITIAL SITE SKETCH

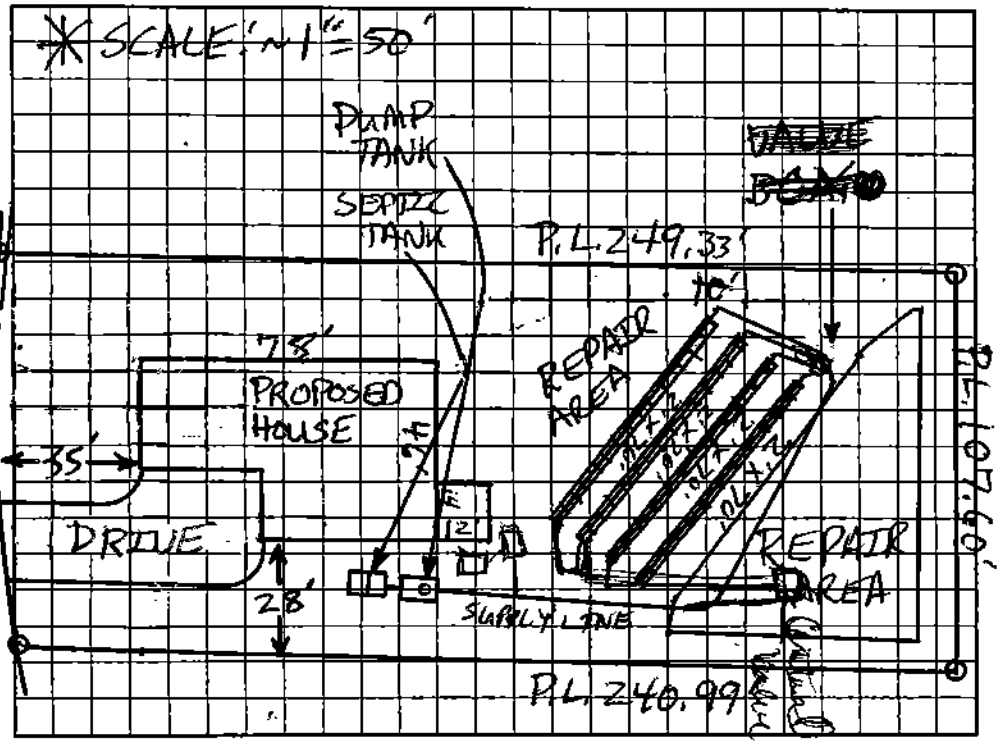

AS BUILT SKETCH

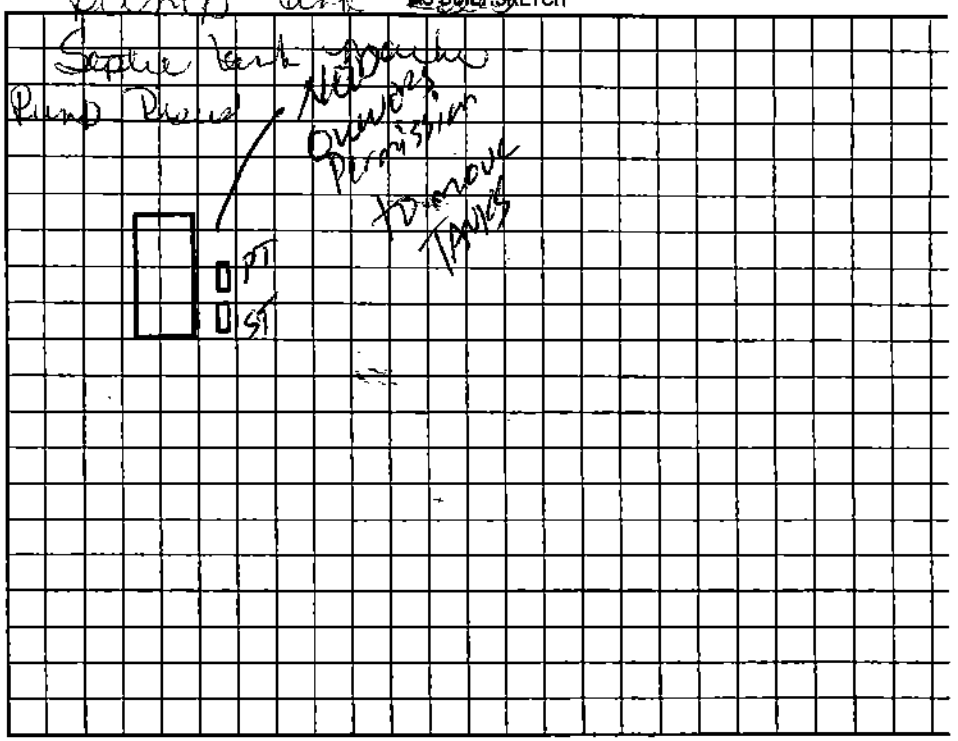

Permit can be suspended or revoked if any false information is supplied toward securing the permit/any unauthorized changes are made to the site/any unauthorized changes are made in the installation of the system. Improveme Permit with plat valid without expiration. Improvement Permit with site plan valid for sixty months. Authorization to Construct is valid for a period equal to that of Improvement Permit – not to exceed sixty months.

Signed: Scott Broerman date 5-2-03 Installed by: C & G GRADING

Improvement Permit by: Patrick Mitchell date 05/01/03 Operation Permit by: Greg Cook date 10-27-06

Authorization to Construct by: Patrick Mitchell date 05/01/03 Existing System Inspection by: date

HEALTH DEPT. COPY: WHITE OWNER COPY (FINAL): YELLOW OWNER COPY (INITIAL): PINK