IREDELL COUNTY HEALTH DEPARTMENT

CF 902-9224 CHRIS 130.00 Paid

STATESVILLE 704-878-5305 MOORESVILLE 704-664-5281

IMPROVEMENT PERMIT / AUTHORIZATION TO CONSTRUCT / OPERATION PERMIT / EXISTING SYSTEM INSPECTION

PERMIT# 127721 PIN# 4629694892 Matt DATE 5-13-05

OWNER OR CONTRACTOR Pride Homes Inc. PHONE: Business 341-8528 Home 664-1808

ADDRESS 578 Normandy Rd Mooresville NC 28117

LOCATION Perth Rd TL State Park Rd TL Wildlife Bay TR into Wildlife Subdivision TL DeerRun on left

SUBDIVISION Wildlife Bay BLOCK / SECTION I LOT 16 LOT AREA SITE CLASS. PS DESIGN FLOW 480gpd L.T.A.R. .3

Septic Tank: 1000 Gallons: STB 2-22-05 Date 10/2

Pump Tank: 1000 Gallons; PT 17 Date 6-29-05

Pump Make: Goulds Model WE03111M Serial No 586/28860

Nitrification Field: No Fields 1 Square Feet 1200' Linear Feet 400'

No Lines 5@80' Trench Width 36" Max Trench Bottom Depth 36" Gravel Depth N/A

☒ New System ☐ Repair System Type: I, II, III, IV, V, VI

System Description: Pump-PM-25% Red.

Repair System Description: Same

Maintenance Agreement Required: ☐ Yes ☒ No

☒ House/Mod. Home No. Bedrooms 4

☐ Mobile Home No. Bathrooms 3

☐ Business No. Employees

☐ Other


☐ Slab ☒ Crawl Space ☐ Basement w/plumbing ☐ Basement wo/plumbing

Water Supply: ☐ Individual ☒ Public ☒ Community

Comments/Conditions: Keep Septic System at least 10' from PL & 10' from house.

Comments/Conditions: ★ Replaces expired permit dated 10-6-98 # 076985 TUFF TITE Filter Mfold

INITIAL SITE SKETCH Scale 1:50

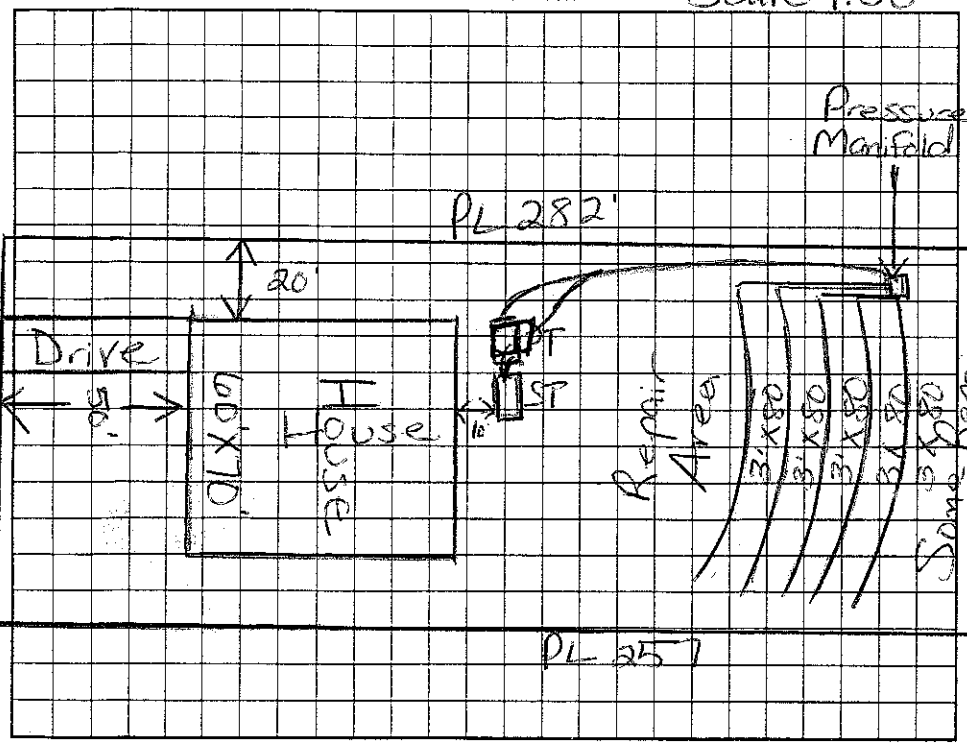

AS BUILT SKETCH

SYSTEM INSTALLED 10' OFF MARKERS (CORNERS. CHRIS STAKED & LAYED THEM UP ON THE P/L & SYSTEM WAS 10' OFF. FRONT WAS SURVEYED, BACK WAS LOT MARKERS, V/D LINES & TRENCHES 9-16-05.

V/D PRESSURE 1-18-06

ENJOY TUFF TITE V/D

Permit can be suspended or revoked if any false information is supplied toward securing the permit/any unauthorized changes are made to the site/any unauthorized changes are made in the installation of the system. Improvement Permit with plat valid without expiration. Improvement Permit with site plan valid for sixty months. Authorization to Construct is valid for a period equal to that of Improvement Permit – not to exceed sixty months.

Signed: [signature] date 5-16-05 Installed by: C&S GRADING

Improvement Permit by: Marian H. Dotson RS date 5/13/05 Operation Permit by: [signature] date 1-18-06

Authorization to Construct by: Marian H. Dotson RS date 5/13/05 Existing System Inspection by: date

HEALTH DEPT. COPY: WHITE OWNER COPY (FINAL): YELLOW OWNER COPY (INITIAL): PINK