IREDELL COUNTY HEALTH DEPARTMENT

STATESVILLE 704-878-5305 (C) MOORESVILLE 704-664-5281

(A) IMPROVEMENT PERMIT / AUTHORIZATION TO CONSTRUCT / OPERATION PERMIT / EXISTING SYSTEM INSPECT

PERMIT# 115063 PIN# 4629-70-7119 DATE 9-25-0

OWNER OR CONTRACTOR CRAIG M. ROSEMAN PHONE: Business 704-534-1499 Home 704-896-0773

ADDRESS 31121 SHEARER ROAD, DAVIDSON, NC 28036

LOCATION US 21 S, TR PERTH RD, TR STATE PARK RD, TL MORRISON FARM RD, BEAR RIGHT AT CIRCLE, LOT ON RIGHT A

SUBDIVISION MORRISON POINT BLOCK / SECTION ____ LOT 34 LOT AREA 0.78 ACRES SITE CLASS. PS DESIGN FLOW 360 L.T.A.R. 0.25 GPD/

Septic Tank: 1000 Gallons; STB 794 Date 9-22-03

Pump Tank: 1000 Gallons; PT 27 Date 9-31-03

Pump Make: LIBERTY Model ____ Serial No. ____

Nitrification Field: No Fields 1 Square Feet EQUIP 1440 Linear Feet 240

No Lines THREE Trench Width 24" Max Trench Bottom Depth 36" Gravel Depth SAND 24"

☑ New System ☐ Repair System Type: I, II, III, (IV), V, VI

System Description: 50% REDUCTION LOW-PRESSURE

Repair System Description: 50% REDUCTION, LOW-PRESSURE

Maintenance Agreement Required: ☑ Yes ☐ No

☑ House/Mod. Home No. Bedrooms 3

☐ Mobile Home No. Bathrooms 3.5

☐ Business No. Employees ____

☐ Other ____


☐ Slab ☑ Crawl Space ☐ Basement w/plumbing ☐ Basement wo/plumbing

Water S ☑ Indivi ☐ Public ☐ Com WEL


Comments:/Conditions: (1) EXISTING WELL TO BE ABANDONED ACCORDING TO 15A NCAC 2C.0100 & SUBMIT FORM GW-30. (2) INSTALL 50% REDUCTION SYSTEM USING 54 PIPS PANELS USING LOW-PRESS. DISTRIBUTION (3) SEE ATTACHED SHEETS FOR PUMP REQUIREMENTS &

Comments:/Conditions: LOW-PRESSURE DISTRIBUTION (4) A CONTRACT SHA BE EXECUTED BETWEEN SYSTEM OWNER & A MANAGEMENT ENTITY PRIOR TO ISSUANCE OF OPERATION PERMIT (5) N WATER LINE SHALL BE PLACED CENTER OF DRIVEWA

INITIAL SITE SKETCH

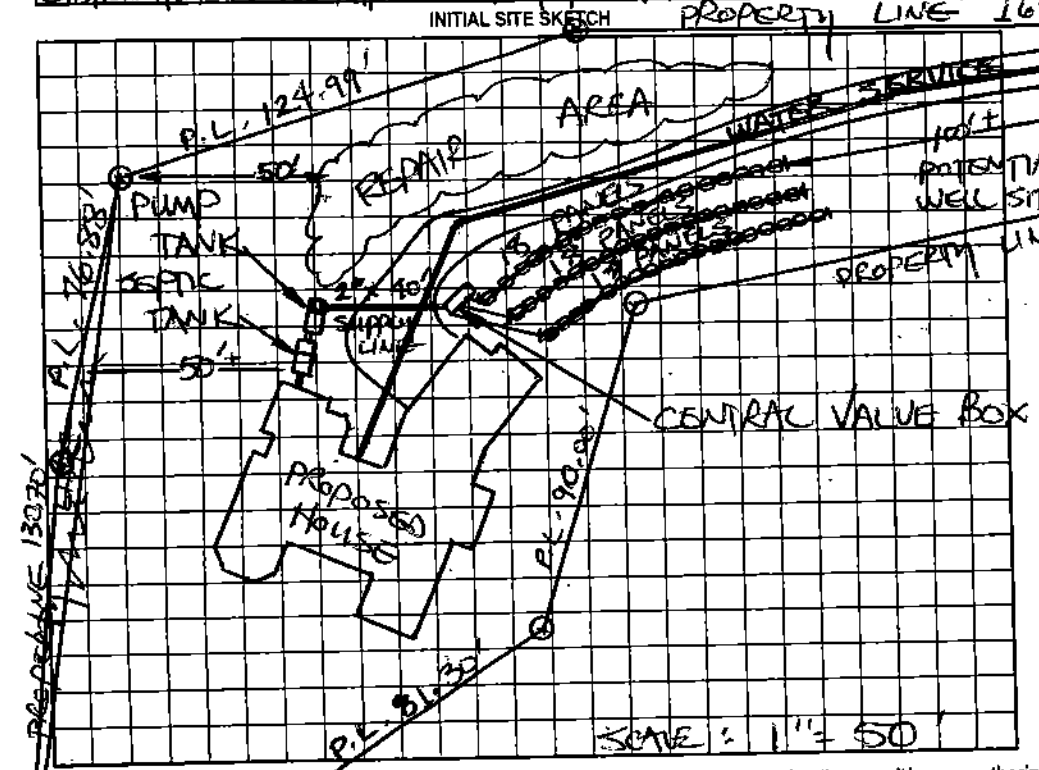

AS BUILT SKETCH

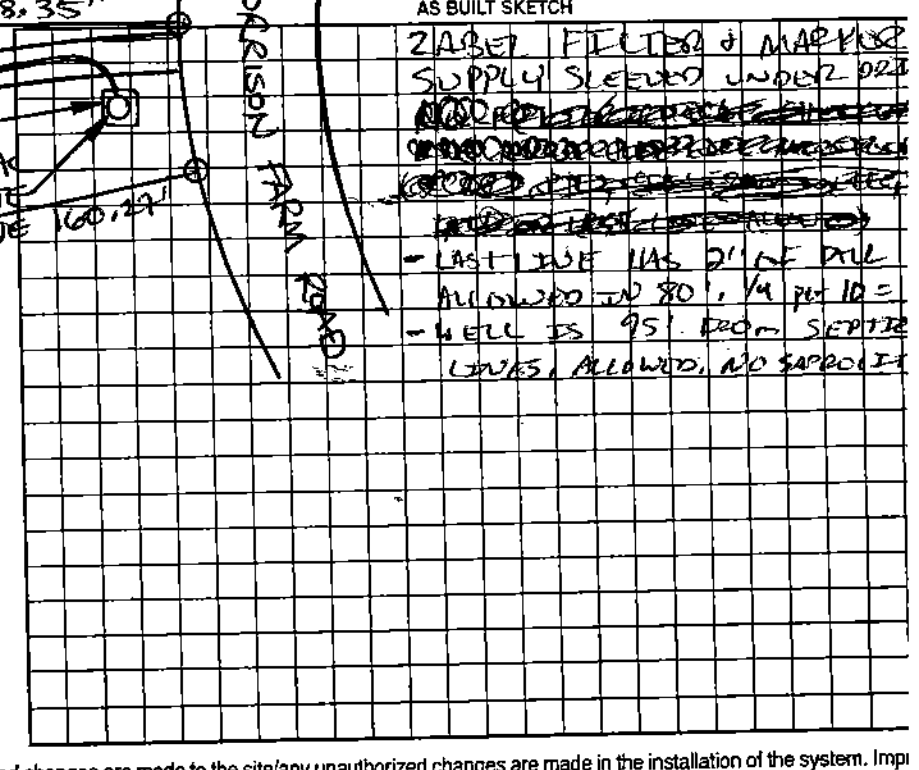

Permit can be suspended or revoked if any false information is supplied toward securing the permit/any unauthorized changes are made to the site/any unauthorized changes are made in the installation of the system. Impr

Permit with plat valid without expiration. Improvement Permit with site plan valid for sixty months. Authorization to Construct is valid for a period equal to that of Improvement Permit – not to exceed sixty months.

Signed: Craig M. Roseman date 9-25-03

Improvement Permit by: STEVE HEDRICK date 9-25-03

Authorization to Construct by: STEVE HEDRICK 9-30-03

Installed by: LITTLE'S LANDSCAPING 10-27-2003

Operation Permit by: STEVE HEDRICK date 10-2

Existing System Inspection by: ____ date ____

HEALTH DEPT. COPY: WHITE OWNER COPY (FINAL): YELLOW OWNER COPY (INITIAL): PINK