IREDELL COUNTY HEALTH DEPARTMENT

STATESVILLE 704-878-5305 MOORESVILLE 704-664-5281

IMPROVEMENT PERMIT / AUTHORIZATION TO CONSTRUCT / OPERATION PERMIT / EXISTING SYSTEM INSPECTION

PERMIT# 25953 PIN# 4029700895 DATE 7-15-98

OWNER OR CONTRACTOR Allan P. Ackerman PHONE: Business Home 892 4203

ADDRESS 19511-103 Wave Runner Cornelius N.C.

LOCATION Perth Rd TR State Pk TL Morrison Fm Rd TR Red Bud lot on left

SUBDIVISION Allendale Pt. BLOCK / SECTION LOT 35 LOT AREA .58 acres SITE CLASS. PS DESIGN FLOW 360 L.T.A.R. .3

Septic Tank: 1000 Gallons; STB 797 Date 6-19-98

Pump Tank: Gallons; PT Date

Pump Make: Model Serial No.

Nitrification Field: No Fields 1 Square Feet 400 Linear Feet 200

No Lines 3 Trench Width 24" Max Trench Bottom Depth 36" Gravel Depth N/A

☑ New System ☐ Repair System Type: I, II, III, IV, V, VI

System Description: Gravity Panel

Repair System Description: LPP Panel

Maintenance Agreement Required: ☐ Yes ☑ No

☑ House/Mod. Home No. Bedrooms 3

☐ Mobile Home No. Bathrooms 2 1/2

☐ Business No. Employees

☐ Other


☐ Slab ☐ Crawl Space ☑ Basement w/plumbing ☐ Basement wo/plumbing

Water Supply: ☐ Individual ☐ Public ☑ Community well next door

Comments:/Conditions:

Replaces permit issued 1-30-97


INITIAL SITE SKETCH

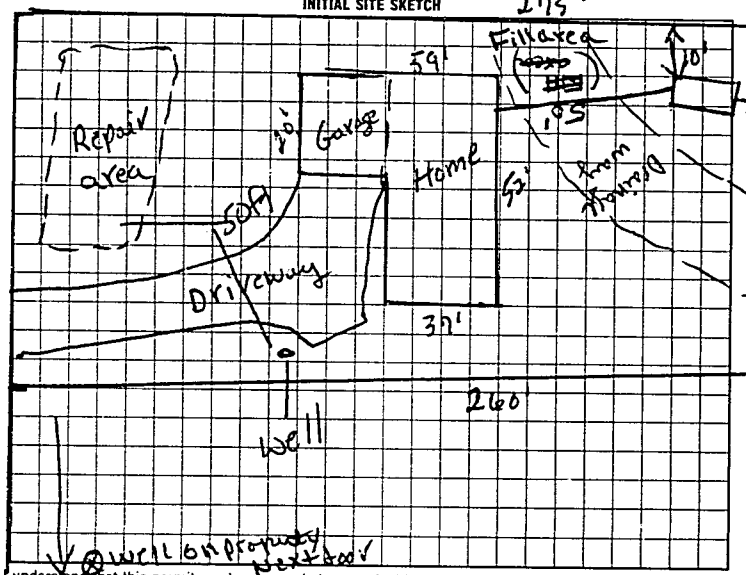

Comments:/Conditions:

Dist. Box with speed levelers

AS BUILT SKETCH

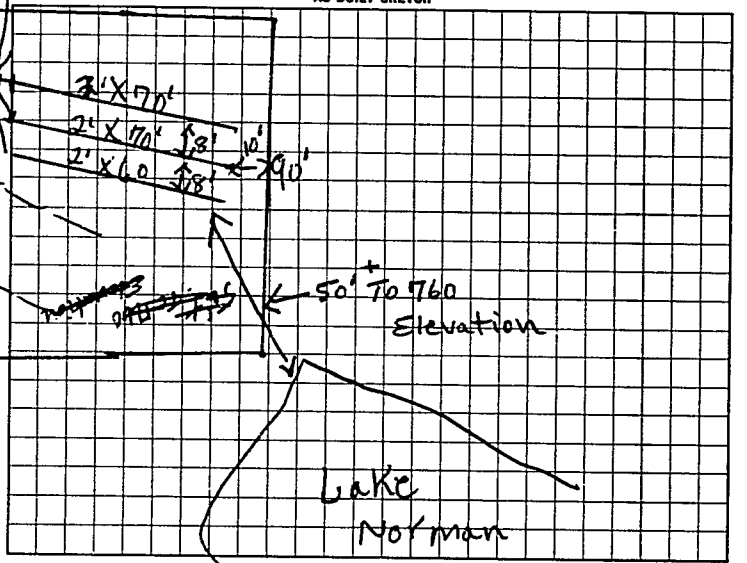

I understand that this permit can be suspended or revoked if any false information is supplied toward securing the permit/any unauthorized changes are made to the site/any unauthorized changes are made in the installation of the system. Improvement Permit with plat valid without expiration. Improvement Permit with site plan valid for sixty months. Authorization to Construct is valid for a period equal to that of Improvement Permit – not to exceed sixty months.

Signed: X Allan P Ackerman date

Improvement Permit by: L. C. Moore date 7-15-98

Authorization to Construct by: L. C. Moore date 7-15-98

Installed by: Reade Eudy

Operation Permit by: [illegible] date 9-28-98

Existing System Inspection by: date

HEALTH DEPT COPY (FINAL) GREEN INSPECTION COPY (FINAL) YELLOW OWNER COPY (FINAL) PINK INSPECTION COPY (INITIAL) PINK OWNER COPY (INITIAL) GOLD

S S E E 0 0