IREDELL COUNTY HEALTH DEPARTMENT

STATESVILLE 704-878-5305 MOORESVILLE 704-664-5281

IMPROVEMENT PERMIT / AUTHORIZATION TO CONSTRUCT / OPERATION PERMIT / EXISTING SYSTEM INSPECTION

PERMIT# Repair PIN# 4629-70-9405 Work #(704) 878-4599 DATE 9/5/03

OWNER OR CONTRACTOR Melvin Benfield Roberts PHONE: Business — Home (704) 528-9094

ADDRESS 887 Morrison Farm Rd Troutman, N.C. 28166

LOCATION 215 to Troutman (1) State Park Rd (2) (2) Morrison Farm Rd, take right fork, on right Circle drive Red House

SUBDIVISION Morrison Pt BLOCK / SECTION — LOT 37 LOT AREA _____ SITE CLASS. PS DESIGN FLOW 360 L.T.A.R. Eff.

Septic Tank: Ex (1000) Gallons; STB _____ Date _____

Pump Tank: _____ Gallons; PT _____ Date _____

Pump Make: _____ Model _____ Serial No. _____

Nitrification Field: No Fields 1 Square Feet 600 Linear Feet 100

No Lines 2 @ 50ft Trench Width 24" Max Trench Bottom Depth — Gravel Depth N/A

☐ New System ☒ Repair System Type: I, II, III, IV, V, VI

System Description: _____

Repair System Description: Gravity, 50% reduction

Maintenance Agreement Required: ☐ Yes ☒ No

☒ House/Mod. Home No. Bedrooms 3-5

☐ Mobile Home No. Bathrooms ____

☐ Business No. Employees ____

☐ Other _____


☐ Slab ☐ Crawl Space ☒ Basement w/plumbing ☐ Basement wo/plumbing

Water Supply: ☒ Individual ☐ Public ☐ Community


Comments:/Conditions: (1) Add 2 - 50ft lines of PPBS (Pond 5) (2) Replace dist. box and add 3 drop boxes. (3) Install Subsurface drainage on Rt side of house

Comments:/Conditions: - Added (2) 50ft lines of PPBS. Installed New line into ex. dist. box for New Lines that were added to Septic system. Line 3 Feeds into Line 4 when septic system is full.

INITIAL SITE SKETCH

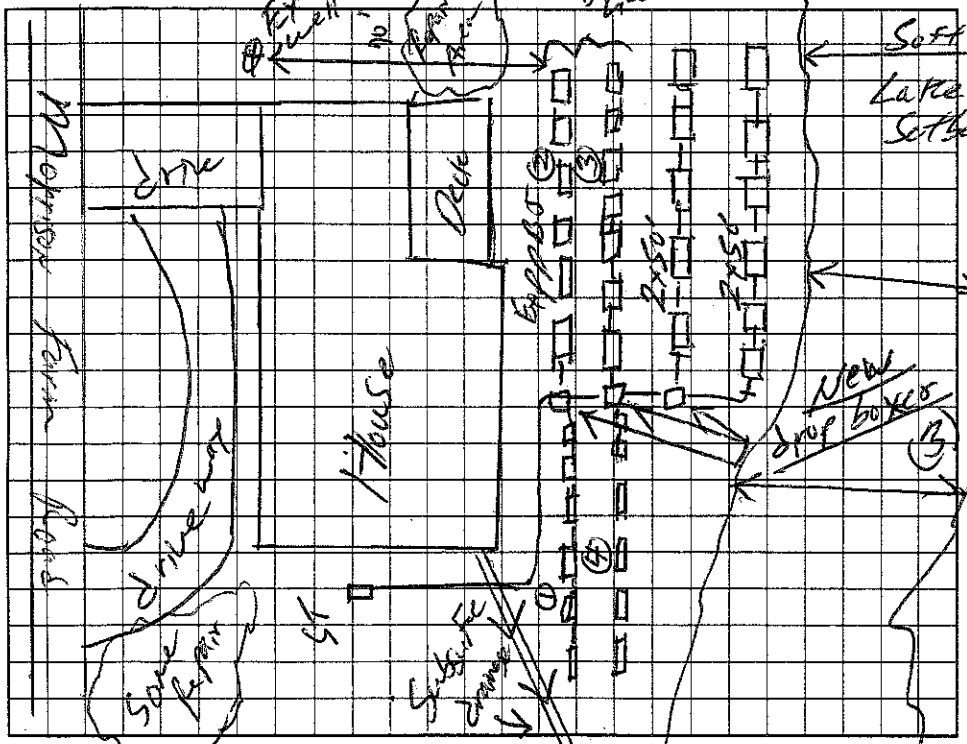

AS BUILT SKETCH (not to scale)

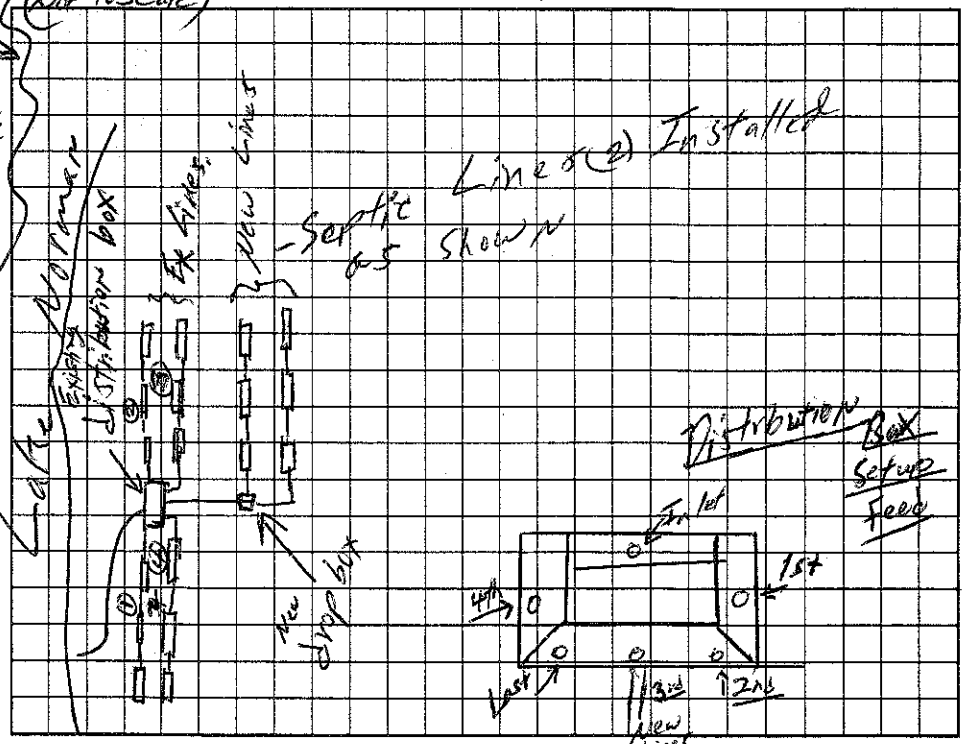

Permit can be suspended or revoked if any false information is supplied toward securing the permit/any unauthorized changes are made to the site/any unauthorized changes are made in the installation of the system. Improvement Permit with plat valid without expiration. Improvement Permit with site plan valid for sixty months. Authorization to Construct is valid for a period equal to that of Improvement Permit – not to exceed sixty months.

Signed: Melvin Benfield Roberts date 9/5/03 Installed by: Wes Lytton

Improvement Permit by: William O. Johnson date 9/8/03 Operation Permit by: Bill Johnson date 8/27/04

Authorization to Construct by: William O. Johnson date 9/5/03 Existing System Inspection by: _____ date _____

HEALTH DEPT. COPY: WHITE OWNER COPY (FINAL): YELLOW OWNER COPY (INITIAL): PINK