four #1's

58649

IREDELL COUNTY HEALTH DEPARTMENT

STATESVILLE 704-878-5305 MOORESVILLE 704-664-5281

IMPROVEMENT PERMIT / CERTIFICATE OF COMPLETION / OPERATION PERMIT / EXISTING SYSTEM INSPECTION

PROPERTY DESCRIPTION NO. 19828 DATE 11-6-95 TAX MAP NO. 3C-8-A-38 Watershed: WS-IV ☐ No

OWNER OR CONTRACTOR ALAN B. BENDEL PHONE: Business 878-0330 Home (610) 820-9496 CA

ADDRESS 1319 N VAN BUREN ST. ALLENTOWN PA 18103

LOCATION STATE PARK ROAD TO MORRISON FARM ROAD TO END, BEAR (R) (ALEXANDER CIRCLE) 2ND LOT ON (R)

SUBDIVISION MORRISON POINT BLOCK / SECTION ____ LOT 38 LOT AREA 0.52 ACRES SITE CLASS. PS DESIGN FLOW 360 L.T.A.R. 0.3 GPD/FT²

Septic Tank: 1000 Gallons; STB 794 Date 4-16-96

Pump Tank: 1000 Gallons; PT 727 Date 5-14-96

Pump Make: LIBERTY Model 6LA Serial No. 7419

Nitrification Field: No Fields 1 Square Feet 1200 Linear Feet 200

No Lines 5 Trench Width 24" Max Trench Bottom Depth 32" SAND Depth 6" MIN

☑ New System ☐ Repair System Type: I, II, ☑ III, IV, V, VI

System Description: PUMP-FED PPBPS

Repair System Description: PUMP-FED PPBPS

Maintenance Agreement Required: ☐ Yes ☑ No

☐ Slab ☐ Crawl Space ☑ Basement w/plumbing ☐ Basement wo/plumbing

☑ House/Mod. Home No. Bedrooms 3

☐ Mobile Home No. Bathrooms 2

☐ Business No. Employees ____


☐ Other ____

Water Supply: ☑ Individual ☐ Community ☐ Public WELL

Comments: (1) INSTALL AS PPBPS PANELS IN FIVE LINES ON CONTOUR (2) SEE ATTACHED SHEETS FOR PUMP & PRESSURE MANIFOLD REQUIREMENTS (3) NO FILL DIRT ALLOWED OVER DRAINFIELD.

Comments: ALL COMPONENTS CHECKED & PUMP CYCLED ON 6-18-96 EXCEPT POWER BOX & ALARM.

INITIAL SITE SKETCH

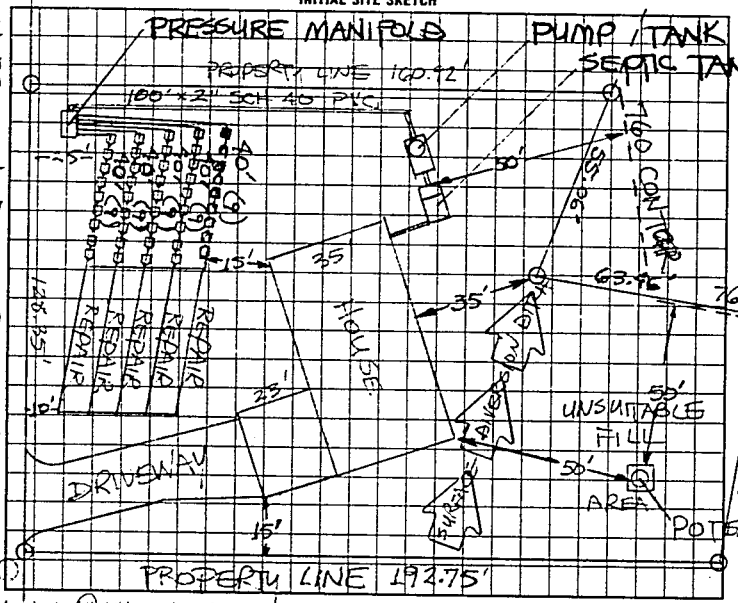

AS BUILT SKETCH

SYSTEM INSTALLED ACCORDING TO INITIAL SITE SKETCH

I understand that this permit can be suspended or revoked if any false information is supplied toward securing the permit/any unauthorized changes are made to the site/any unauthorized changes are made in the installation of the system. AUTHORIZATION TO CONSTRUCT IS VALID FIVE (5) YEARS FROM DATE OF ISSUANCE. IMPROVEMENT PERMIT HAS NO EXPIRATION DATE.

Signed: [signature]

Improvement Permit by: STEVE HEDRICK date 11-6-95

AUTHORIZATION TO CONSTRUCT

~~Existing System Inspection~~ by: STEVE HEDRICK date 11-6-95

Installed by: A-1 BACKHOE

~~Certificate of Completion~~ by: ____ date ____

Operation Permit by: STEVE HEDRICK date 6-24-96

HEALTH DEPT COPY: WHITE INSPECTION COPY (FINAL) GREEN OWNER COPY (FINAL) YELLOW INSPECTION COPY (INITIAL): PINK OWNER COPY (INITIAL): GOLD

12520