IREDELL COUNTY HEALTH DEPARTMENT

STATESVILLE 704-878-5305 MOORESVILLE 704-664-5281

IMPROVEMENT PERMIT / CERTIFICATE OF COMPLETION / OPERATION PERMIT / EXISTING SYSTEM INSPECTION

PROPERTY DESCRIPTION NO. 25663 DATE 11-22-96 TAX MAP NO. 3C-6-A-120 Watershed: ☐ Yes ☒ No

OWNER OR CONTRACTOR Crescent Resources Inc. PHONE: Business 704-382-3004 Home

ADDRESS 400 S. Tryon St. Charlotte, N.C.

LOCATION Morrison FM R TR Penicillin Point 3rd lot Left

SUBDIVISION Lake Norman BLOCK / SECTION 17 LOT 855 LOT AREA .35 ans SITE CLASS. PS DESIGN FLOW 480 L.T.A.R. .3

Septic Tank: 1000 Gallons; STB 1012 Date 5-9-97

Pump Tank: Gallons; PT Date

Pump Make: Model 1200 Serial No. 400

Nitrification Field: No Fields 1 Square Feet ~~450~~ Linear Feet ~~750~~

No Lines 6 Trench Width 36" Max Trench Bottom Depth 36" Gravel Depth N/A

☒ New System ☐ Repair System Type: I, II, III, IV, V, VI

System Description: Gravity Chamber

Repair System Description: 11 Panels

Maintenance Agreement Required: ☐ Yes ☐ No

☒ House/Mod. Home 3 No. Bedrooms ~~4~~ 3

☐ Mobile Home No. Bathrooms 3

☐ Business No. Employees

☐ Other


☐ Slab ☒ Crawl Space ☐ Basement w/plumbing ☐ Basement wo/plumbing

Water Supply: ☐ Individual ☐ Community ☐ Public


Comments:

Comments: ↓ System Sized for 3 Bedroom House

INITIAL SITE SKETCH

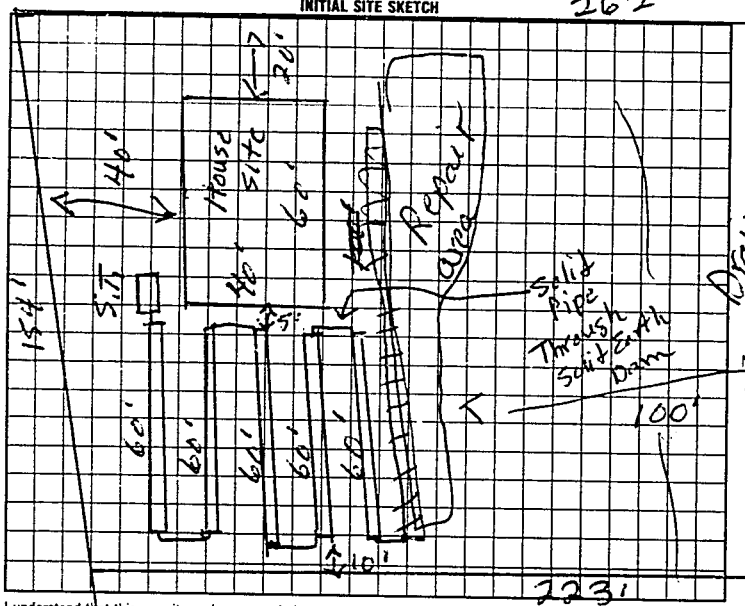

AS BUILT SKETCH

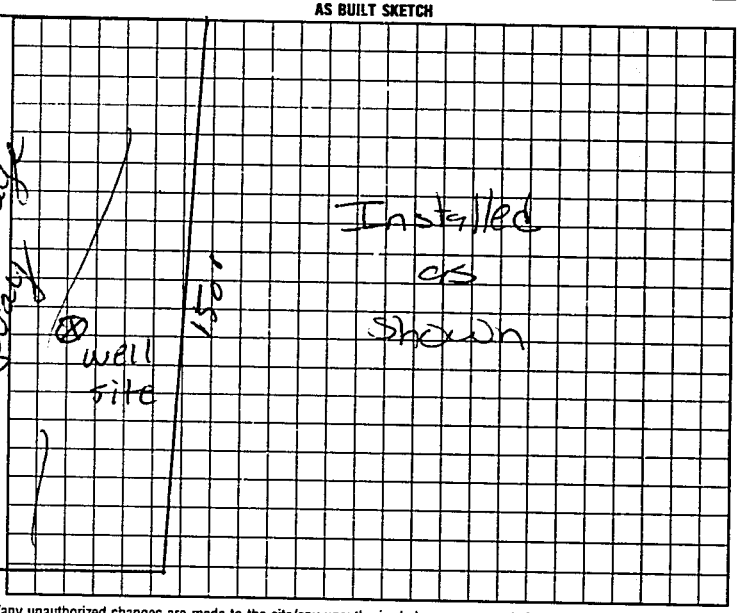

I understand that this permit can be suspended or revoked if any false information is supplied toward securing the permit/any unauthorized changes are made to the site/any unauthorized changes are made in the installation of the system. Improvement Permit is valid for 60 months from date of issuance.

Signed: Tony Gaul (PS) 12-4-96 Installed by: A-1 Backhoe

Improvement Permit by: D.C. Moore date 11-22-96 Certificate of Completion by: date

Existing System Inspection by: D.C. Moore date 11-22-96 Operation Permit by: Mark C. Offs date 7-10-97

Authorization to Const.

HEALTH DEPT. COPY: WHITE INSPECTION COPY (FINAL): GREEN OWNER COPY (FINAL): YELLOW INSPECTION COPY (INITIAL): PINK OWNER COPY (INITIAL): GOLD

Authorization to Count Expires 60 mos from S.C.W.