IREDELL COUNTY HEALTH DEPARTMENT

THIS PERMIT VOIDS PREVIOUS ISSUED 6-8-96

STATESVILLE 704-878-5305 MOORESVILLE 704-664-5281

IMPROVEMENT PERMIT / AUTHORIZATION TO CONSTRUCT / OPERATION PERMIT / EXISTING SYSTEM INSPECTION

PERMIT# 23009-1988 PIN# TAX MAP 25-A-51 (PT) PIN 4629710545 DATE 7-14-99

OWNER OR CONTRACTOR JOHN H. VAN RAVENSTEIN PHONE: Business Home 873-5269

ADDRESS 1180 FREE NANCY AVENUE, STATESVILLE, NC 28677

LOCATION W.S. R/S, TR PERTH, TR STATE PARK, TL MORRISON FARM, TR ALLENDALE, S/D ON RIGHT

SUBDIVISION VAN RAVENSTEIN BLOCK / SECTION LOT 2 LOT AREA LIMITED SITE CLASS PS DESIGN FLOW 480 L.T.A.R. 0.30 GPD/FT²

Septic Tank: 1000 Gallons; STB 794 Date 9-6-00
Pump Tank: 1000 Gallons; PT 283 Date 9-27-00
Pump Make: Model Serial No.
Nitrification Field: No Fields 1 Square Feet 60 to 1600 Linear Feet 270
No Lines SIX Trench Width 24" Max Trench Bottom Depth 36" Gravel Depth 3 AND 6"

☑ New System ☐ Repair System Type: I, II, III, IV, V, VI
System Description: PPBPS, pump-FED
Repair System Description: PPBPS, LPP
Maintenance Agreement Required: ☐ Yes ☑ No
☐ Slab ☐ Crawl Space ☑ Basement w/plumbing ☐ Basement w/o plumbing


☑ House/Mod. Home No. Bedrooms 4
☐ Mobile Home No. Bathrooms 3
☐ Business No. Employees
☐ Other 4 BR ONLY

Water Supply: ~~Individual~~ ☐ Public ☐ Community WELL


Comments/Conditions: ① KEEP SYSTEM MAXIMUM FEASIBLE DISTANCE FROM WELL, NOT LESS THAN 50 FEET. ② INSTALL SIXTY (60) PPBPS PANELS IN SIX (6) EQUAL LENGTH LINES ON CONTOUR. ③ SEE ATTACHED SHEETS FOR PUMP & PRESSURE MANIFOLD REQUIREMENTS.

Comments/Conditions: * septic tank above pump tank - plumbing comes out back house - checked lines, set pressure mo

INITIAL SITE SKETCH

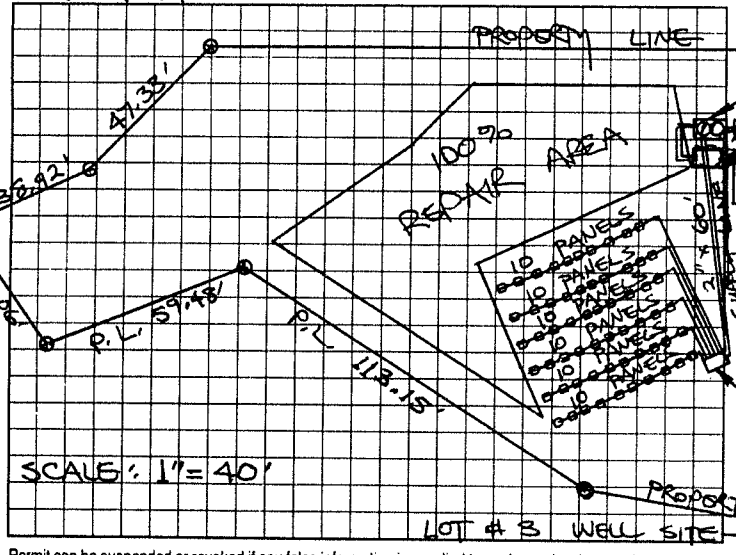

AS BUILT SKETCH

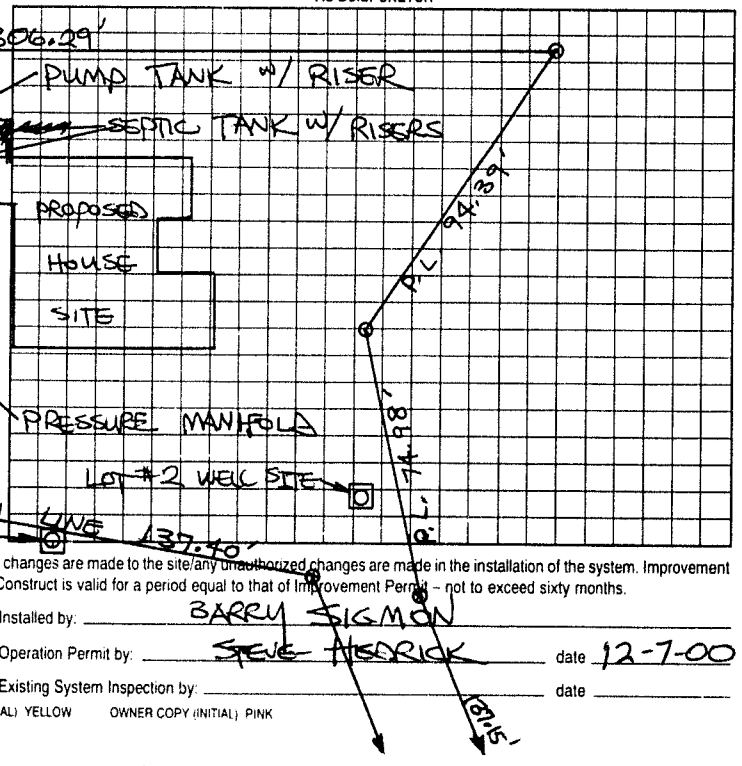

Permit can be suspended or revoked if any false information is supplied toward securing the permit/any unauthorized changes are made to the site/any unauthorized changes are made in the installation of the system. Improvement Permit with plat valid without expiration. Improvement Permit with site plan valid for sixty months. Authorization to Construct is valid for a period equal to that of Improvement Permit – not to exceed sixty months.

Signed: DV date 7-20-99 Installed by: BARRY SIGMON

Improvement Permit by: STEVE HEDRICK date 7-14-99 Operation Permit by: STEVE HEDRICK date 12-7-00

Authorization to Construct by: STEVE HEDRICK date 7-14-99 Existing System Inspection by: date

HEALTH DEPT COPY WHITE OWNER COPY (FINAL) YELLOW OWNER COPY (INITIAL) PINK