pd 101597 $50

IREDELL COUNTY HEALTH DEPARTMENT

STATESVILLE 704-878-5305 MOORESVILLE 704-664-5281

IMPROVEMENT PERMIT / CERTIFICATE OF COMPLETION / OPERATION PERMIT / EXISTING SYSTEM INSPECTION

PROPERTY DESCRIPTION NO. 25664 & 69854 DATE 10-9-97 TAX MAP NO. 3C-6-A-131 Watershed: ☐ Yes ☐ No

OWNER OR CONTRACTOR Davis Mitchell PHONE: Business Home mobile phone 361-8454

ADDRESS Hwy 21 S Mooresville N.C.

LOCATION Morrison Fm Rd TR Pencellin Point 2nd lot left

SUBDIVISION Lake Norman BLOCK / SECTION LOT 17 LOT AREA .856 SITE CLASS. .197ac DESIGN FLOW 300 L.T.A.R. .3

Septic Tank: 1000 Gallons; STB 1017 Date 9-25-97
Pump Tank: 1000 Gallons; PT 17 Date 11-13-97
Pump Make: Model Serial No.
Nitrification Field: No Fields 1 Square Feet 900 Linear Feet 300
No Lines 4 Trench Width 36" Max Trench Bottom Depth 24" Gravel Depth N/A

☐ New System ☐ Repair System Type: I, II, III, IV, V, VI
System Description: Pump To Chambers
Repair System Description: " " "
Maintenance Agreement Required: ☐ Yes ☒ No

☒ House/Mod. Home No. Bedrooms 3
☐ Mobile Home No. Bathrooms 3
☐ Business No. Employees
☐ Other


☐ Slab ☒ Crawl Space ☐ Basement w/plumbing ☐ Basement wo/plumbing

Water Supply: ☒ Individual ☐ Community ☐ Public


Comments: Replace Permit issued TO Crescent Resources issued 1-23-97
See Attached Sheets for Pump Tank Pressure manifold Hardware which become Part of This Permit. 298

Comments:

INITIAL SITE SKETCH

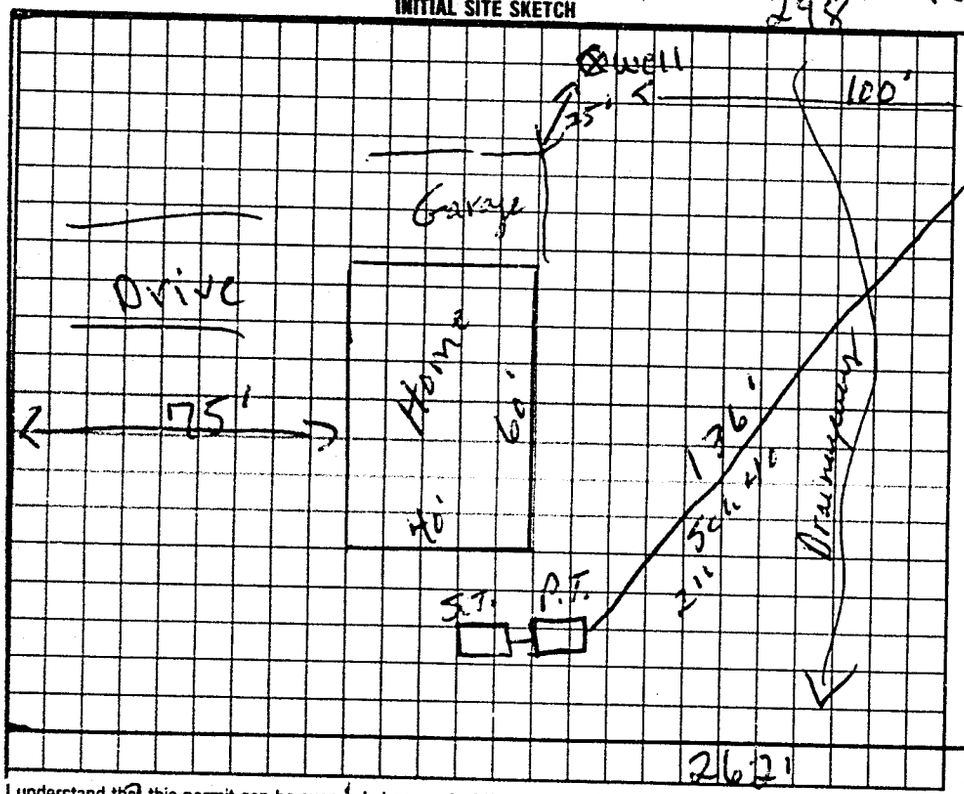

AS BUILT SKETCH

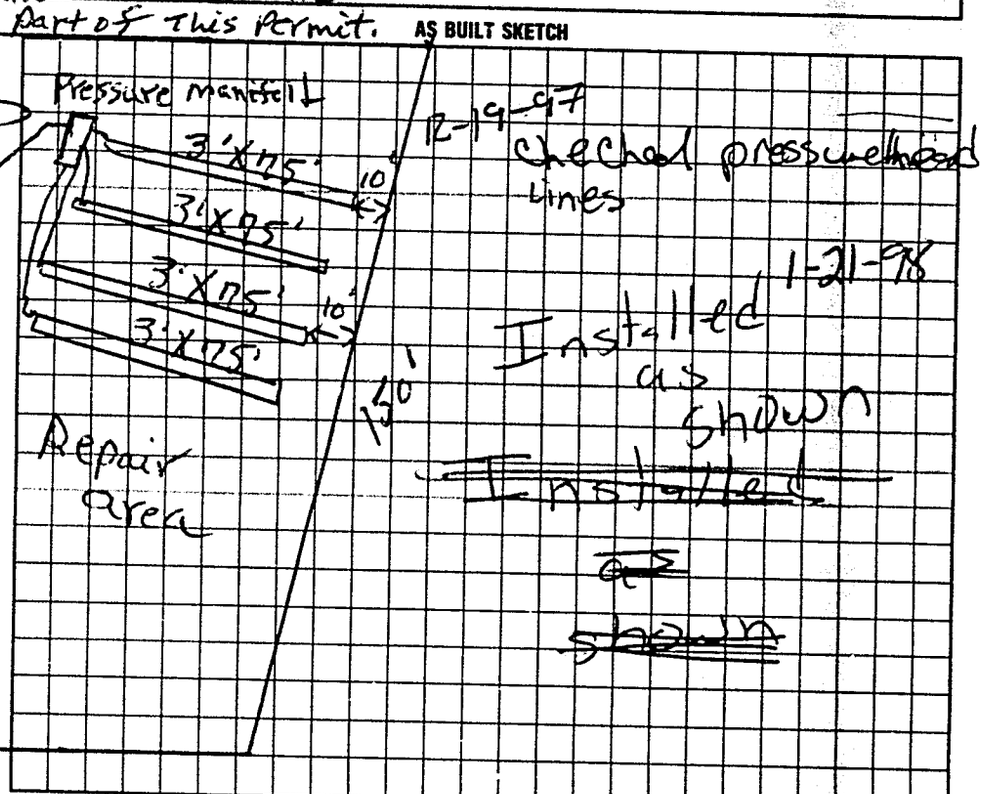

I understand that this permit can be suspended or revoked if any false information is supplied toward securing the permit/any unauthorized changes are made to the site/any unauthorized changes are made in the installation of the system. Improvement Permit is valid for 60 months from date of issuance.

Signed: Dawn Mitchell

Improvement Permit by: P.C. Moore date 10-9-97

Existing System Inspection by: P.C. Moore date 10-9-97

to count.

Installed by: A-1 Backhoe date 1-21-98

Certificate of Completion by: date

Operation Permit by: Mary Coates date

HEALTH DEPT. COPY: WHITE INSPECTION COPY (FINAL): GREEN OWNER COPY (FINAL): YELLOW INSPECTION COPY (INITIAL): PINK OWNER COPY (INITIAL): GOLD

Authorization to count. Expires 60 mos. from issue