IREDELL COUNTY HEALTH DEPARTMENT

STATESVILLE 704-878-5305 MOORESVILLE 704-664-5281

IMPROVEMENT PERMIT / AUTHORIZATION TO CONSTRUCT / OPERATION PERMIT / EXISTING SYSTEM INSPECTION

PERMIT# 100489 PIN# 4629 71 8074 DATE 6-2-2001

OWNER OR CONTRACTOR PATOKA HOUSING PHONE: Business Home (704) 875-0424

ADDRESS 12619 LONGSTOCK CT, HUNTERSVILLE, NC 28078

LOCATION US 21 S, TR PERTH, TR STATE PARK RD, TL MORRISON FARM RD, TR RED BUD LANE, 2ND LOT ON LEFT

SUBDIVISION ALLENDALE POINT BLOCK / SECTION LOT 38 LOT AREA .054 ACRE SITE CLASS PS DESIGN FLOW 360 L.T.A.R. 0.60 GPD/FT²

Septic Tank: 1000 Gallons: STB 354 Date 5-31-01
Pump Tank: Gallons: PT Date
Pump Make: Model Serial No.
Nitrification Field: No Fields 1 Square Feet 600 Linear Feet 200
No Lines FOUR Trench Width 36" Max Trench Bottom Depth 36" Gravel Depth 12"

☑ New System ☐ Repair System Type: I (II) III IV V VI
System Description: CONVENTIONAL GRAVITY
Repair System Description: CONVENTIONAL GRAVITY
Maintenance Agreement Required: ☐ Yes ☑ No
☐ Slab ☑ Crawl Space ☐ Basement w/plumbing ☐ Basement wo/plumbing


☑ House/Mod Home No. Bedrooms 3
☐ Mobile Home No. Bathrooms 3
☐ Business No. Employees
☐ Other

Water Supply: ☑ Individual ☐ Public ☐ Community
WELL


Comments/Conditions: ①CONTACT HEALTH DEPARTMENT AFTER CLEARING & PRIOR TO INSTALLATION TO FLAG DRAINFIELD ② KEEP SYSTEM MINIMUM 100 FEET FROM WELL (.1956(6)(9))

Comments/Conditions: SEPTIC TANK WITH RISER INSTALLED USING "POLY LOK" FILTER

INITIAL SITE SKETCH

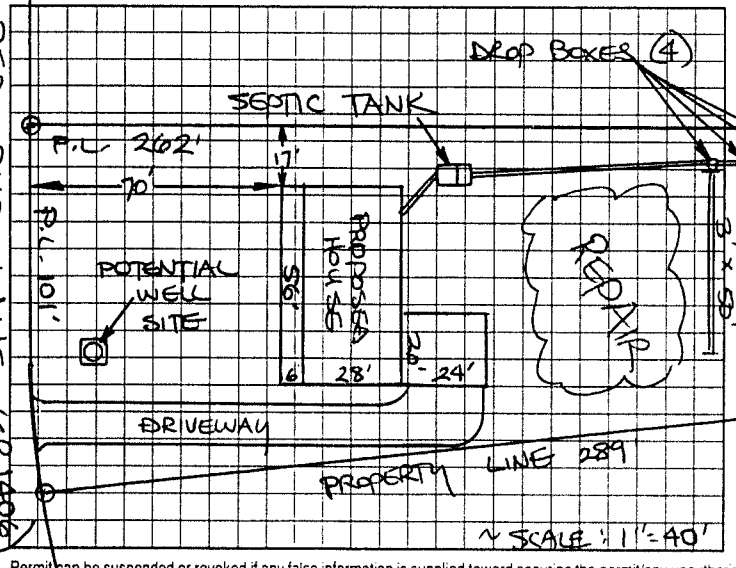

AS BUILT SKETCH

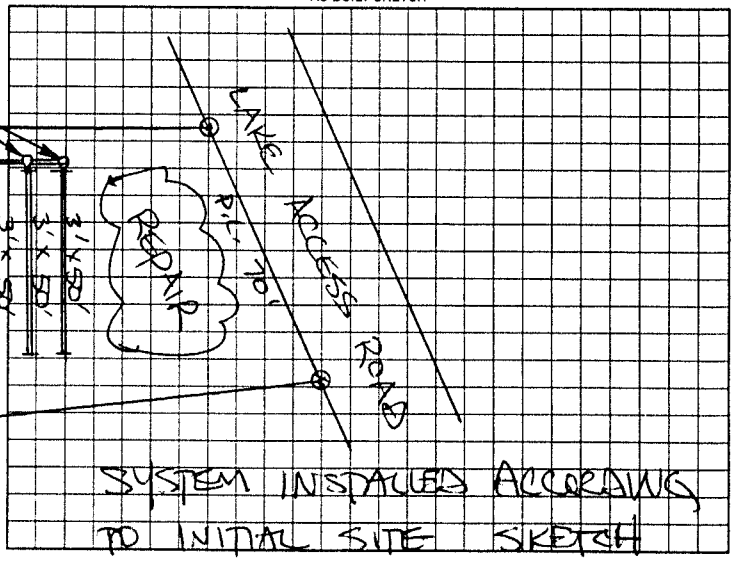

Permit can be suspended or revoked if any false information is supplied toward securing the permit/any unauthorized changes are made to the site/any unauthorized changes are made in the installation of the system. Improvement Permit with plan valid without expiration. Improvement Permit with site plan valid for sixty months. Authorization to Construct is valid for a period equal to that of Improvement Permit – not to exceed sixty months.

Signed: Rhonda Patoka date 6-8-01 Installed by: G & M ENTERPRISES

Improvement Permit by: STEVE HEDRICK date 6-2-2001 Operation Permit by: STEVE HEDRICK date 12-31-01

Authorization to Construct by: STEVE HEDRICK date 6-2-2001 Existing System Inspection by: date

HEALTH DEPT COPY WHITE OWNER COPY (FINAL) YELLOW OWNER COPY (INITIAL) PINK